

299

# STATE WELL REPORT

## Part 1

### Driller's Log

Mississippi Department of Environmental Quality  
Office of Land and Water Resources  
P.O. Box 2309  
Jackson, MS 39225-2309  
(601)961-5210  
(601)360-0535 (fax)

#### For Office Use Only:

Well #: L37CA17

Aquifer: \_\_\_\_\_

E-Log #: \_\_\_\_\_

RECEIVED

MAR 08 2019

State Law requires that this report be prepared by the license holder responsible for the work and filed with the Department at the above address within 30 days of completion of drilling of the well or borehole.

County: Tate

Permit #: \_\_\_\_\_

Driller: Jerry W. Mason

Date drilling completed: 2-7-19

|  |  |
|--|--|
| <b>Well Owner Information</b><br>(Landowner if borehole is not for a water well)<br>Owner Name: <u>Trent Ross</u><br>Mailing Address: <u>101 Springwood</u><br><u>Caldwater</u> MS 38618<br>City State Zip Code<br>Telephone No. <u>(701) 508-6207</u> | <b>Well or Borehole Location</b><br>BYOLWR<br>Latitude: <u>34°44'28.85" N</u> Longitude: <u>89°51'39.10" W</u><br>Method of Lat/Long (check one): Conventional Survey _____<br>USGS quad _____, Hand-held GPS _____, Survey-grade GPS _____<br><u>SX NW 1/4 NW 1/4, Sec 17 T 45 R 6W</u><br><u>2 1/2</u> Miles <u>NW</u> of <u>Bowman</u><br>(Distance) (Direction) (Nearest Town) |
|--|--|

**Well / Borehole Data**

Date drilling started: 2-7-19 Date drilling completed: 2-7-19 Hole depth: 140' Hole diameter: 2"

Location of the source of any surface water used for drilling: N/A

Method of dosing and volume of Chlorine used in drilling and development: 50 ppm and greater

Logs run (circle all applicable): (No log run) Electric Gamma Ray Density Sonic Neutron Other: \_\_\_\_\_

Name of organization running log(s): N/A

Purpose of borehole (circle one): Water Well Geotechnical/Geological Investigation Ground Source Heat Pump  
Seismic Survey Other (describe) \_\_\_\_\_

*If drilling is not related to water well construction, skip the remainder of this block*

Purpose of Well (circle all applicable): Home Industrial Public Supply Irrigation Fish Culture

Other (describe): \_\_\_\_\_

If a flowing well, method of flow regulation: Valve N/A Other (describe) \_\_\_\_\_

Static Water Level: 55 feet [above or (below) land surface] Date measured: 2-7-19  
(circle one)

Method of measurement (circle one): Steel tape Electric tape Air line Other (describe): String/weight

Well depth: 140 Well grouted to a depth of: 50 feet Type of grout (circle one): Neat Cement Bentonite Mix

Casing length: 120 feet Casing diameter: 4 inches Type of casing: PVC

Screen length: 20 feet Screen diameter: 4 inches Type of screen: PVC

Screen slot size: .010 inches Setting depth: From 120 feet to 140 feet

Type of completion (circle all applicable): Gravel packed Underreamed Open hole Natural Development

Other (describe): N/A

Top of lap pipe or reduction in casing: N/A feet


*If telescoped or more than one screen, describe on next page*

County: \_\_\_\_\_  
 Permit #: \_\_\_\_\_

**For Office Use Only:**  
 Well #: C417

The sketch below only required for water wells


If well telescopes, show depths on sketch.

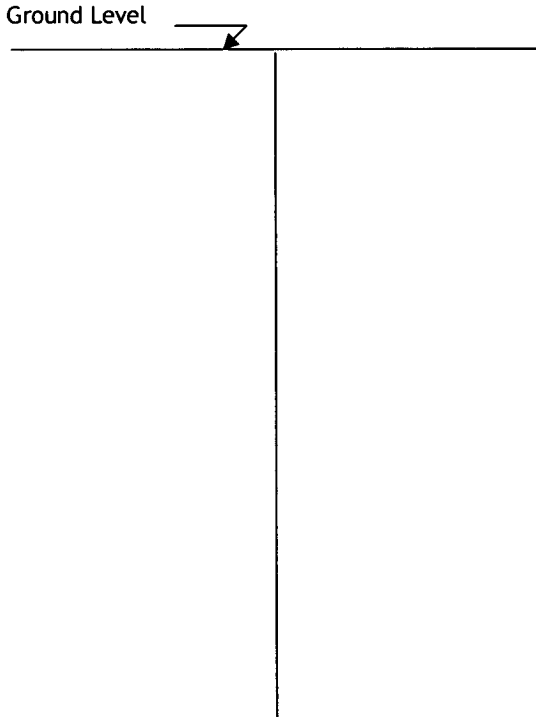

Description of formations encountered must be provided for all wells and boreholes, unless specifically exempted by regulations

| Description of Formations Encountered | From (depth) | To (depth) |
|---------------------------------------|--------------|------------|
| clay dirt                             | Ground level | 20         |
| white sand                            | 20           | 60         |
| Rock                                  | 60           | 61         |
| Blue clay                             | 61           | 90         |
| Rock                                  | 90           | 92         |
| Blue clay                             | 92           | 110        |
| Rock                                  | 110          | 111        |
| white sand                            | 111          | 140        |
|                                       |              |            |
|                                       |              |            |
If more than one screen, show location of each on sketch

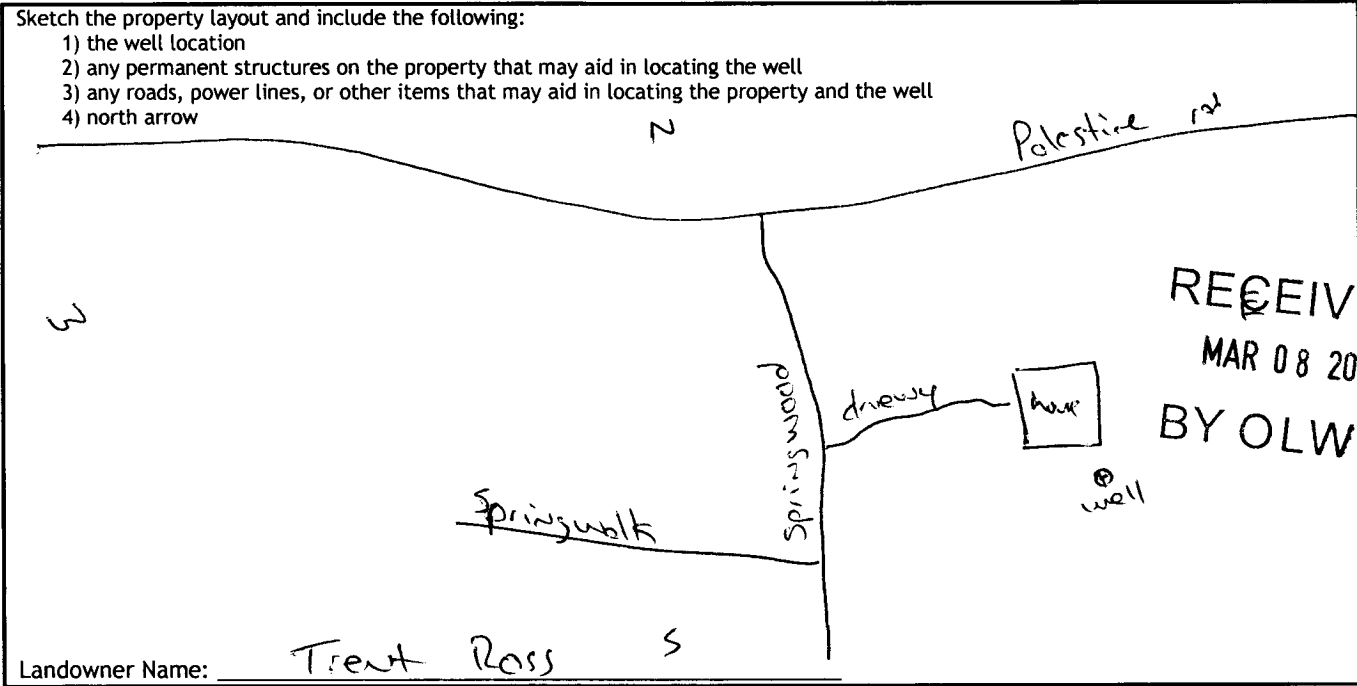

I HEREBY CERTIFY that the well/borehole was drilled, constructed, and completed in accordance with all applicable requirements of the Mississippi Department of Environmental Quality and the Mississippi Department of Health regulations, if applicable, and state laws.

Jones W. Masen 0-620      3-4-19      Jones W. Masen  
 Print Name of Responsible Licensee and License No.      Date      Signature of Licensee

# STATE WELL REPORT

## Part 2

**Pump Installer's Completion Report**  
Mississippi Department of Environmental Quality  
Office of Land and Water Resources  
P.O. Box 2309  
Jackson, MS 39225-2309  
(601)961-5210  
(601) 360-0535 (fax)

### For Office Use Only:

Well #: 1370417  
Aquifer: \_\_\_\_\_

RECEIVED

MAR 08 2019

This part of the report must be completed by a licensed water well contractor or a licensed pump installer. A copy of Part 1 of the report must be attached and both parts filed with the Department at the above address within 30 days of well completion.

| Well Owner Information                  | Well Location  |
|---|--|
| Owner Name: <u>Trent Ross</u>           | Latitude: <u>34°44'28.85"N</u> Longitude: <u>89°51'39.10"W</u>   |
| Mailing Address: <u>101 Springwood</u>  | Method of Lat/Long (check one): Conventional Survey _____, USGS quad _____, Hand-held GPS <input checked="" type="checkbox"/> , Survey-grade GPS _____ |
| <u>Coldwater</u> <u>ms</u> <u>38618</u> | <u>SW 1/4</u> NW 1/4, Sec <u>17</u> T <u>4S</u> R <u>6W</u>  |
| City State Zip Code                     | <u>2.2</u> Miles <u>NW</u> of <u>Bowman</u>  |
| Telephone No. <u>(901) 508-6207</u>     | (Distance) (Direction) (Nearest Town)  |

**Pump Type (circle one)**

Submersible Turbine Air Lift Centrifugal Flowing Well Jet Piston Rotary Other (describe): \_\_\_\_\_

Date Pump Installed: 2-7-19 Rated Pump Capacity: 10 Gallons Per Minute

Is This Pump (circle one):  New Repaired Replacement

**Power Type (circle one)**

Electric Diesel Gasoline Natural Gas Tractor PTO Windmill Other (describe): \_\_\_\_\_

Horse Power Rating of Motor: 3/4 Setting Depth: 80 feet Number of Stages: 8

**Pump Test Data for Non Flowing Well**

Date Well Tested: 2-7-19 Duration of Pump Test (minimum 4 hours): 24 hours

Static Water Level (A): 55 Feet Below Land Surface Pumping Water Level (B): N/A Feet Below Land Surface

Drawdown [(B) - (A)]: N/A Feet Below Land Surface Test Pumping Rate: 10 Gallons Per Minute

Method of measurement (circle one): Steel tape Electric tape Air line Other (describe): String Weight

**Pump Test Data for Flowing Well**

Measured shut in head: N/A feet.

Well yielded 10 GPM with a drawdown of N/A feet after 24 hours of pumping

**Meter Installation**

Meter Manufacturer: N/A Meter Serial Number: N/A

Meter Model Number/Name: N/A Type of Meter: N/A

Totalizer Register Unit and Multiplier Factor (AF x .001, gal x 1000, etc): N/A

Installation Date: N/A Meter installed by: N/A

Is This Meter (circle one): New Repaired Replacement

*Important: By submitting the above information you are certifying that this meter was installed to manufacturer standards. For agricultural wells, a list of approved meters is on the MDEQ website.*

I HEREBY CERTIFY that the above statements are true to the best of my knowledge.

Jones w. Mason 0-620 3-4-19 Jones w. Mason

Print Name of Pump Installer and License No. (if applicable) Date Signature of Pump Installer