

TATE

C 2000

7-60

WATER WELL DRILLERS LOG

Date: July, 1960, Driller: Lawrence Crockett, County Tate.

(Name)

0057

(1) Owner of Land: Hulbert Sowell
(Name)

(Address)

(2) Location: 5 1/4 N 1/4, Sec 24 T4 R6
4 miles North of Indigo
(distance) (direction) (Nearest Town)

(3) Topography: X
(Hilly) (Flat) (Level)

(4) Purpose of Well: Home
(Domestic Irrigation
Municipal, Industrial, Other)

| Description & Color of Materials Sand, Clay, Red Clay, Shell, etc. | Thick- ness Feet | Depth Feet |
|---|------------------------|---------------|
| Clay Red Top | 110 | 10 |
| Red sand & gravel | 8 | 8 |
| Clay & sand | 60 | 60 |
| Sand | 15 | 15 |

Information upon completion of well:

(1) Diameter 3 inches.


(2) Total Depth 153 feet.

(3) Water Level 100 feet below top of ground.

(4) Cased to _____, Size _____

(5) Screen: Size 6 Slot, Length 6 ft

(6) Were any formations sealed against pollution?
_____ yes, X no.

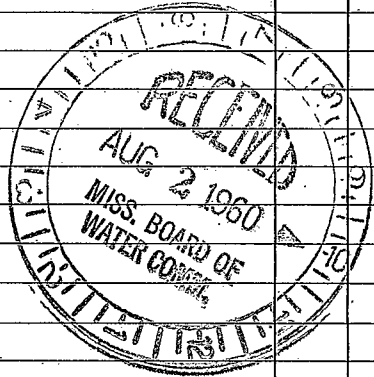

If YES depth of formation _____
Why _____

Drillers Remarks: _____

Well No. 2

(Use Back Side)

