

TATE  
C 2001  
7-60

WATER WELL DRILLERS LOG

Date: July, 1960, Driller: Lawrence Rockett County Tate  
(Name 0037)

(1) Owner of Land: Lillian Scruggs  
(Name)  
Independence Miss  
(Address)

(2) Location: S 1/2 NE 1/4, Sec. 22, T 4 R 6 E  
2 miles North, of Independence  
(distance) (direction) (Nearest Town)

(3) Topography: V  
(Hilly) (Flat) (Level)

(4) Purpose of Well: Drain  
(Domestic Irrigation, Municipal, Industrial, Other)

Description & Color of Materials Sand, Clay, Red Clay, Shell, etc.	Thick- ness Feet	Depth Feet
<u>Reworked in</u>		
<u>old well sand</u>		
<u>course at bottom</u>		

Information upon completion of well:

(1) Diameter 3 inches.


(2) Total Depth 10.5 feet.

(3) Water Level 60 feet below top of ground.

(4) Cased to \_\_\_\_\_, Size \_\_\_\_\_.

(5) Screen: Size 90, Length 6 ft.

(6) Were any formations sealed against pollution?  
\_\_\_\_\_ yes, \_\_\_\_\_ no.

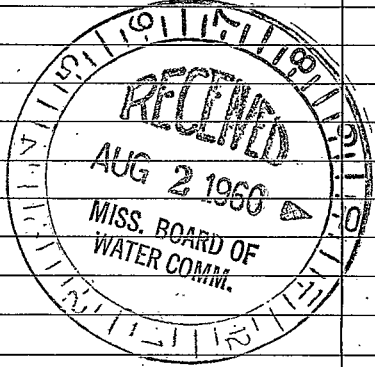

If YES depth of formation \_\_\_\_\_  
Why \_\_\_\_\_

Drillers Remarks: Coarse sand.  
at bottom

Well No.      

(Use Back Side)

