

TATE

C 2004
6-61

WATER WELL DRILLERS LOG

C 300
502

Date: June, 1961, Driller: James C. Best County: Tate
(Name)

(1) Owner of Land: Charles Suggs
(Name)

Calumetes Miss Rt. 2
(Address)

(2) Location: 1/4, 1/4, Sec: 34 T4R6
1/2 miles west of Indian
(distance) (direction) (Nearest Town)

(3) Topography: X
(Hilly) (Flat) (Level)

(4) Purpose of Well: Home
(Domestic Irrigation
Municipal, Industrial, Other)

Description & Color of Materials Sand, Clay, Red Clay, Shell, etc.	Thick- ness Feet	Depth Feet
<u>Red clay</u>	<u>42</u>	<u>42</u>
<u>gravel</u>	<u>8</u>	<u>50</u>
<u>white sand</u>		<u>58</u>

Information upon completion of well:

(1) Diameter 2 inches.

(2) Total Depth 90 feet.

(3) Water Level 45 feet below top of ground.

(4) Cased to _____, Size _____


(5) Screen: Size 6 1/2 Length 5 ft.

(6) Were any formations sealed against pollution?
_____ yes, ✓ no.

If YES depth of formation _____

Why _____

Drillers Remarks: _____

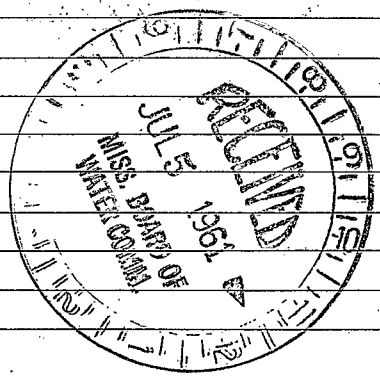

(Use Back Side)

Well No.

