

TATE

C 200e

11-61

WATER WELL DRILLERS LOG

Date: Nov, 1964, Driller: Lamar Cook County Tate
(Name)

(1) Owner of Land: W. H. King
(Name)
Caldwell, Miss
(Address)

(2) Location: NW 1/4, 1/4, Sec. 35-4R6,
1/2 miles S.E., of Indian Lake
(distance) (direction) (Nearest Town)

(3) Topography: (Hilly) (Flat) (Level)

(4) Purpose of Well: Home
(Domestic Irrigation, Municipal, Industrial, Other)

Description & Color of Materials Sand, Clay, Red Clay, Shell, etc.	Thick- ness Feet	Depth Feet
<u>Red Clay</u>	<u>42</u>	
<u>gravel & red sand</u>	<u>40</u>	
<u>white sand</u>	<u>38</u>	

Information upon completion of well:

(1) Diameter 3 inches.

(2) Total Depth 120 feet.

(3) Water Level 85 feet below top of ground.

(4) Cased to _____, Size _____


(5) Screen: Size 10, Length 4

(6) Were any formations sealed against pollution?
_____ yes, no.

If YES depth of formation _____

Why _____

Drillers Remarks: _____

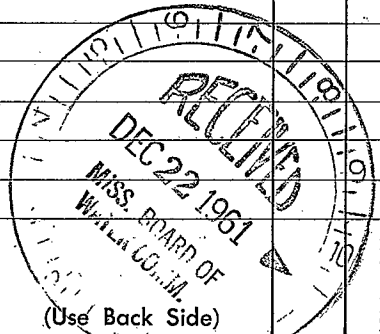

Well No.

(Use Back Side)

