

Late
C2008
11-66

MISSISSIPPI
 BOARD OF WATER COMMISSIONERS
 416 North State Street
 Jackson, Mississippi 39201

WATER WELL DRILLERS LOG

11 19 66 Harris Bros. Late
 date well completed firm name county well located

LANDOWNER: James A. Zimmerman
At. 2 Caldwellwater
 (mailing address)


description of formations encountered	from	to
<u>top soil</u>	<u>0</u>	<u>15</u>
<u>red sand</u>	<u>15</u>	<u>25</u>
<u>white clay & sand</u>	<u>25</u>	<u>80</u>
<u>course white sand</u>	<u>80</u>	<u>90</u>

WELL LOCATION:
 sec 26 T 4 N R 6 E
0 miles independence
 (distance) (direction) (nearest town)

WELL PURPOSE: home
 (home, irrigation, municipal, industrial)


- WELL COMPLETION DATA:
- (1) diameter (inches) 4"
 - (2) total depth (feet) 90
 - (3) static water level (feet) 50 below above top of ground.
 - (4) casing Plastic 83'
 (material) (depth)
4" if telescope see back.
 (size)
 - (5) screen 7' 83'
 (length) (depth to top)
1008 Plastic
 (size) (material)
 - (6) pump 3/4 7
 (HP) (yield gpm)
elec.
 (type power)
 - (7) electric log no
 (yes or no)
 (organization running log)
 - (8) how well bottom plugged back
shot

DRILLERS REMARKS:

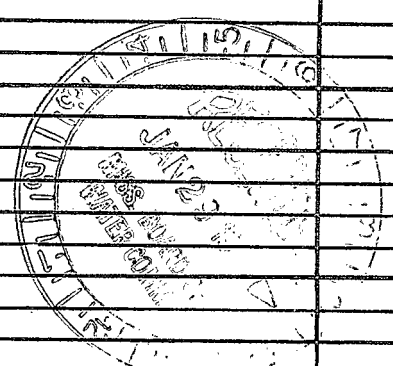

If well telescopes please sketch and show depths.

GROUND LEVEL

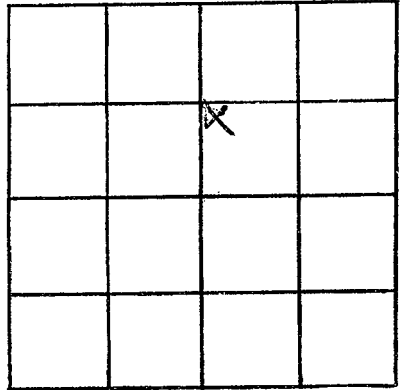

SECTION 26

Please indicate well location X.

ADDITIONAL INFORMATION

If more than one screen, show locations of each on sketch.