

Date
 C 2009
 12-66

MISSISSIPPI
 BOARD OF WATER COMMISSIONERS
 416 North State Street
 Jackson, Mississippi 39201

WATER WELL DRILLERS LOG

12-28 1966 Harris Bros. Sate
 date well completed firm name county well located

LANDOWNER: Ronnie Saugg

description of formations encountered	depth	
	from	to
top soil	0	20
clay + sand	20	50
clay	50	80
fine sand	80	95
coarse w. sand	95	110

pt. 3
Coldwater
 (mailing address)

WELL LOCATION:
 sec. 23 T 4 N R. 6 E
2 miles N of Independence
 (distance) (direction) (nearest town)

WELL PURPOSE: home
 (home, irrigation, municipal, industrial)

WELL COMPLETION DATA:


- (1) diameter (inches) 4
- (2) total depth (feet) 110'
- (3) static water level (feet) 80 ^(below) _(above) top of ground.
- (4) casing Plastic, 103'
 (material) (depth)
4"
 (size) if telescope see back.
- (5) screen 7', 103'
 (length) (depth to top)
008, Plastic
 (size) (material)
- (6) pump 1/4 10
 (HP) (yield gpm)
elec.
 (type power)
- (7) electric log no
 (yes or no)
 (organization running log)
- (8) how well bottom plugged back shot

DRILLERS REMARKS:



If well telescopes please sketch and show depths.

GROUND LEVEL

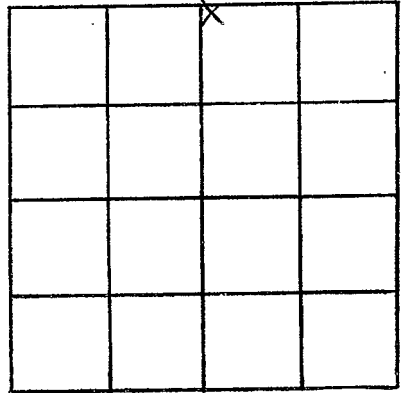

SECTION 23

Please indicate well location X.

ADDITIONAL INFORMATION

If more than one screen,
show locations of each on sketch.