

Date  
C 2010  
7-67

MISSISSIPPI  
 BOARD OF WATER COMMISSIONERS  
 416 North State Street  
 Jackson, Mississippi 39201

WATER WELL DRILLERS LOG

7-19 1967 Harris Zate  
 date well completed firm name county well located

LANDOWNER: Raymond Young  
RT. 3  
Caldwater Miss.  
 (mailing address)


description of formations encountered	from	to
<u>top soil</u>	<u>0</u>	<u>15</u>
<u>red sand</u>	<u>15</u>	<u>30</u>
<u>clay + sand</u>	<u>30</u>	<u>85</u>
<u>Coarse white sand</u>	<u>85</u>	<u>100</u>

WELL LOCATION:  
 sec. 1 T 4 N R 6 E  
 (S) (W)  
5 miles NE of Independence  
 (distance) (direction) (nearest town)

WELL PURPOSE: home  
 (home, irrigation, municipal, industrial)


WELL COMPLETION DATA:  
 (1) diameter (inches) 4  
 (2) total depth (feet) 100'  
 (3) static water level (feet) 60' <sup>(below)</sup> <sub>above</sub> top of ground.  
 (4) casing Plastic, 93'  
 (material) (depth)  
4" if telescope see back.  
 (size)  
 (5) screen 7", 93'  
 (length) (depth to top)  
.008, Plastic  
 (size) (material)  
 (6) pump 3/4, 7  
 (HP) (yield gpm)  
elec.  
 (type power)  
 (7) electric log no  
 (yes or no)  
 (organization running log)  
 (8) how well bottom plugged Back  
shot

DRILLERS REMARKS:

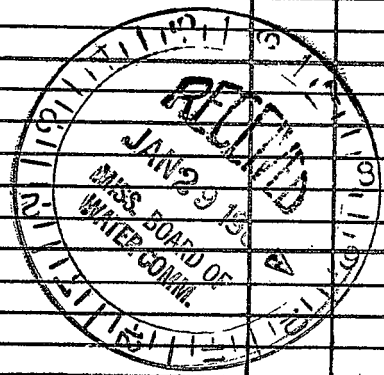

If well telescopes please sketch and show depths.

GROUND LEVEL

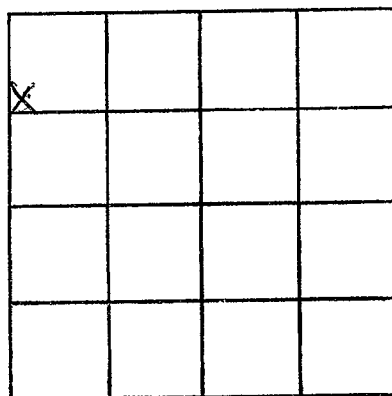

SECTION 1

Please indicate well location X.

ADDITIONAL INFORMATION

If more than one screen, show locations of each on sketch.