

Late  
C 2011  
7-67

MISSISSIPPI  
 BOARD OF WATER COMMISSIONERS  
 416 North State Street  
 Jackson, Mississippi 39201

WATER WELL DRILLERS LOG

7-24 1967 Harris Bros. Late  
 date well completed firm name county well located

LANDOWNER Polly Graham  
RT. 3  
Coldwater, Miss.  
 (mailing address)


description of formations encountered	from	to
<u>top soil</u>	<u>0</u>	<u>20</u>
<u>red sand + gravel</u>	<u>20</u>	<u>35</u>
<u>clay + sand</u>	<u>35</u>	<u>125</u>
<u>white sand</u>	<u>125</u>	<u>140</u>

WELL LOCATION:  
 sec. 15 T. 4 N. R. 6 E.  
3 miles N of Independence  
 (distance) (direction) (nearest town)

WELL PURPOSE: home  
 (home, irrigation, municipal, industrial)


- WELL COMPLETION DATA:
- (1) diameter (inches) 4"
  - (2) total depth (feet) 140'
  - (3) static water level (feet) 100  below  above top of ground.
  - (4) casing Plastic, 133'  
 (material) (depth)  
4"  
 (size) if telescope see back.
  - (5) screen 7', 133'  
 (length) (depth to top)  
1/2" Plastic  
 (size) (material)
  - (6) pump 1/4 7  
 (HP) (yield gpm)  
elec.  
 (type power)
  - (7) electric log no  
 (yes or no)  
 (organization running log)
  - (8) how well bottom plugged back  
shot

DRILLERS REMARKS:

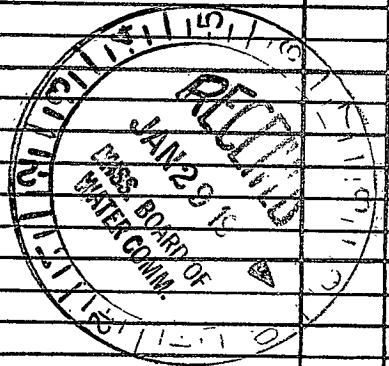

If well telescopes please sketch and show depths.

GROUND LEVEL

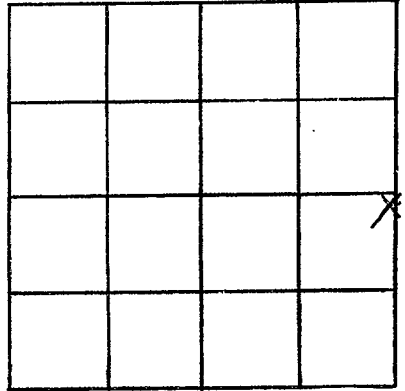

SECTION 15

Please indicate well location X.

ADDITIONAL INFORMATION

If more than one screen, show locations of each on sketch.