

Late

C 2012

7-67

MISSISSIPPI
 BOARD OF WATER COMMISSIONERS
 416 North State Street
 Jackson, Mississippi 39201

WATER WELL DRILLERS LOG

7-22

1967

Harris Bros.

Late

date well completed

firm name

county well located

LANDOWNER: L. W. Turner

Rte. 2

Coldwater, Miss.

(mailing address)

description of formations encountered

from

to

top soil	0	20
white clay + sand	20	80
Coarse white sand	80	100

WELL LOCATION:

sec 34 T 4 N R 6 E
 3/4 miles W of Independence
 (distance) (direction) (nearest town)

WELL PURPOSE: home
 (home, irrigation, municipal, industrial)


WELL COMPLETION DATA:

- (1) diameter (inches) 4
- (2) total depth (feet) 100
- (3) static water level (feet) 60 below
top of ground.
- (4) casing Plastic 93'
" (material) (depth)
4" (size) if telescope see back.
- (5) screen 7' 93'
(length) (depth to top)
1008 Plastic
(size) (material)
- (6) pump 3/4 10
(HP) (yield gpm)
- Elec.
(type power)
- (7) electric log No
(yes or no)

(organization running log)


(8) how well bottom plugged Duck
 shaft

DRILLERS REMARKS:

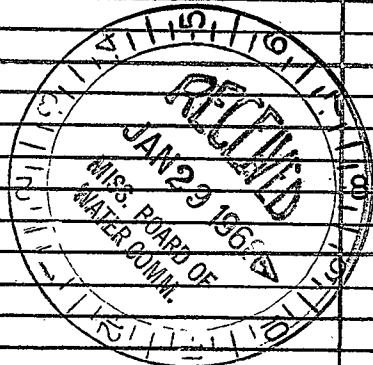

If well telescopes please sketch and show depths.

GROUND LEVEL

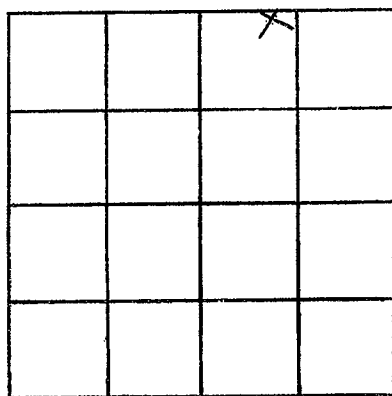

SECTION SP4

Please indicate well location X.

ADDITIONAL INFORMATION

If more than one screen,
show locations of each on sketch.