

Date  
 C 2013  
 7-67

MISSISSIPPI  
 BOARD OF WATER COMMISSIONERS  
 416 North State Street  
 Jackson, Mississippi 39201

WATER WELL DRILLERS LOG

7-15 1967 Harris Zato  
 date well completed firm name county well located

LANDOWNER: B. L. Coleman  
 Pte. 2  
 Coldwater, Miss.  
 (mailing address)

description of formations encountered	from	to
top soil	0	20
red sand	20	45
white clay	45	65
fine sand	65	100
sand + clay	100	125
Coarse Sand	125	140

WELL LOCATION:  
 sec 30 T 4 N R 6 E  
 4 1/2 miles W of Independence  
 (distance) (direction) (nearest town)

WELL PURPOSE: home  
 (home, irrigation, municipal, industrial)

WELL COMPLETION DATA:


(1) diameter (inches) 4  
 (2) total depth (feet) 140  
 (3) static water level (feet) 80 <sup>below</sup> top of ground.  
 (4) casing Plastic, 133 (depth)  
 4" (size) if telescope see back.  
 (5) screen 7' (length), 133' (depth to top)  
 #008, Plastic (size) (material)  
 (6) pump 3/4 (HP), 7 (yield gpm)  
 elec. (type power)  
 (7) electric log no (yes or no)  
 (organization running log)  
 (8) how well bottom plugged Back shot

DRILLERS REMARKS:



If well telescopes please sketch and show depths.

GROUND LEVEL

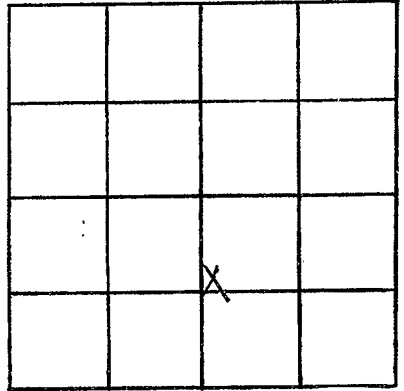

SECTION 30

Please indicate well location X.

ADDITIONAL INFORMATION

If more than one screen,  
show locations of each on sketch.