

Late
C 2014
10-67

MISSISSIPPI
 BOARD OF WATER COMMISSIONERS
 416 North State Street
 Jackson, Mississippi 39201

WATER WELL DRILLERS LOG

10-31 1966 Late
 date well completed firm name county well located


LANDOWNER: S. M. Ferguson
pte. 2
Caldwater
 (mailing address)

description of formations encountered	from	to
<u>top soil</u>	<u>0</u>	<u>20</u>
<u>red sand</u>	<u>20</u>	<u>40</u>
<u>clay + sand</u>	<u>40</u>	<u>80</u>
<u>coarse white sand</u>	<u>80</u>	<u>100</u>

WELL LOCATION:
 sec 34 T 4 N R 0 E
3/4 miles West of Independence
 (distance) (direction) (nearest town)

WELL PURPOSE: Home
 (home, irrigation, municipal, industrial)


- WELL COMPLETION DATA:
- (1) diameter (inches) 4"
 - (2) total depth (feet) 100'
 - (3) static water level (feet) 60 ^{below} _{above} top of ground.
 - (4) casing Plastic, 93'
 (material) (depth)
4"
 (size) if telescope see back.
 - (5) screen 7' 93'
 (length) (depth to top)
.008 Plastic
 (size) (material)
 - (6) pump 3/4 7
 (HP) (yield gpm)
elec.
 (type power)
 - (7) electric log no
 (yes or no)
 - (organization running log)
 - (8) how well bottom plugged rock
shot

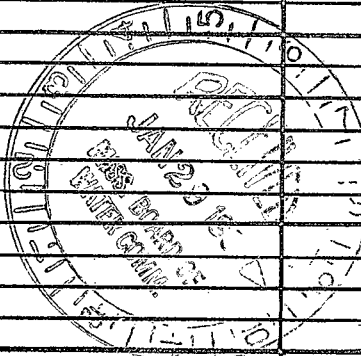

DRILLERS REMARKS:

If well telescopes please sketch and show depths.

GROUND LEVEL

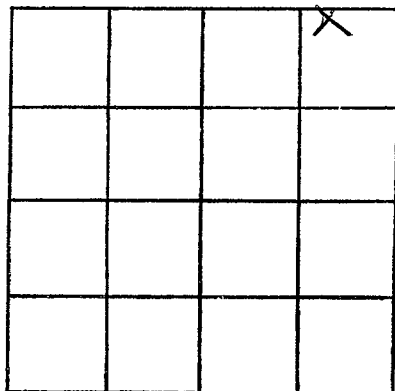

SECTION 34

Please indicate well location X.

ADDITIONAL INFORMATION

If more than one screen,
show locations of each on sketch.