

TATE
 © 2015
 2-68

MISSISSIPPI
 BOARD OF WATER COMMISSIONERS
 416 North State Street
 Jackson, Mississippi 39201

WATER WELL DRILLERS LOG

2-10 19 1968 Harris Bros Tate
 date well completed firm name county well located


LANDOWNER: Ruford Wallace
Independence
P.O.
 (mailing address)

Description of formations encountered	from	to
top soil	0	20
red sand	20	40
clay + sand	40	90
sand	90	100

WELL LOCATION:
 sec 26 T 4 N R 6 E
1/4 miles E of Independence
 (distance) (direction) (nearest town)

WELL PURPOSE: home
 (home, irrigation, municipal, industrial)


- WELL COMPLETION DATA:
- (1) diameter (inches) 4
 - (2) total depth (feet) 100
 - (3) static water level (feet) 100 ^{below}/_{above} top of ground.
 - (4) casing Plastic, 93'
 (material) (depth)
4"
 (size) if telescope see back.
 - (5) screen 7', 93'
 (length) (depth to top)
1008, Plastic
 (size) (material)
 - (6) pump 3/4 7
 (HP) (yield gpm)
elec.
 (type power)
 - (7) electric log NO
 (yes or no)
 (organization running log)
 - (8) how well bottom plugged back
shot

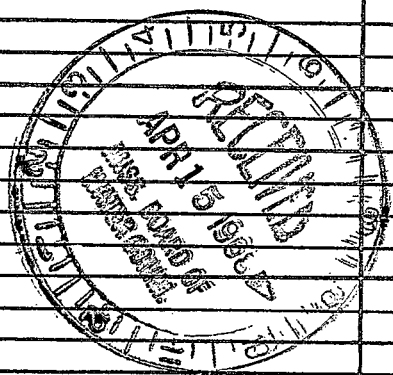

DRILLERS REMARKS:

If well telescopes please sketch and show depths.

GROUND LEVEL

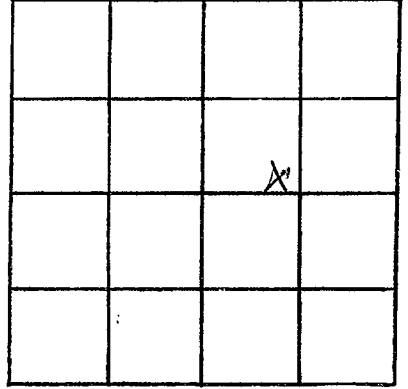

SECTION 21e

Please indicate well location X.

ADDITIONAL INFORMATION

If more than one screen, show locations of each on sketch.