

Date
C 2016
11-4-75

MISSISSIPPI
 BOARD OF WATER COMMISSIONERS
 416 North State Street
 Jackson, Mississippi 39201

WATER WELL DRILLERS LOG

11-4 1975 Shirley Well Co. State
 date well completed firm name county well located

LANDOWNER:
Harry Thompson
Arbuckle, Miss.
 (mailing address)

description of formations encountered	from	to
<u>Red Clay</u>	<u>0</u>	<u>10</u>
<u>Gravel</u>	<u>10</u>	<u>25</u>
<u>Sand + clay</u>	<u>25</u>	<u>150</u>
<u>White Sand</u>	<u>150</u>	<u>200</u>

WELL LOCATION:
 sec 31 T 4 N R. 6 E 15E
3 miles E. of Arbuckle
 (distance) (direction) (nearest town)

WELL PURPOSE: Home
 (home, irrigation, municipal, industrial)

WELL COMPLETION DATA:

- (1) diameter (inches) 4 1/2"
- (2) total depth (feet) 200
- (3) static water level (feet) 160 below top of ground.
- (4) casing Plastic, 200,
 (material) (depth)
 _____ If telescope see back.
 (size)
- (5) screen 4 ft, 196
 (length) (depth to top)
4 1/2", Gravel
 (size) (material)
- (6) pump 1/2 1/2
 (HP) (yield gpm)
220
 (type power)
- (7) electric log no
 (yes or no)


 (organization running log)
- (8) how well bottom plugged Cap

DRILLERS REMARKS:

RECEIVED
 NOV 19 1975

If well telescopes please
sketch and show depths.

GROUND LEVEL

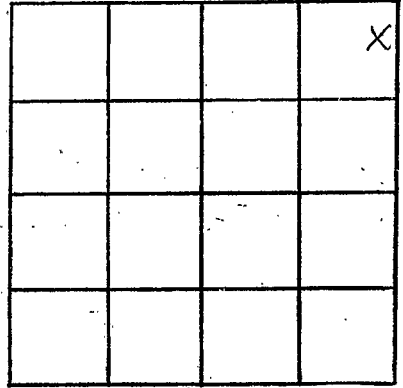

SECTION 31

Please indicate well location X.

ADDITIONAL INFORMATION

If more than one screen,
show locations of each on sketch.