

TATE
 C 2077
 11-18-75

MISSISSIPPI
 BOARD OF WATER COMMISSIONERS
 416 North State Street
 Jackson, Mississippi 39201

WATER WELL DRILLERS LOG

11-18-75
 date well completed

15E
 Lab. Smith & Well Dr.
 firm name


Tate
 county well located

| LANDOWNER: | description of formations encountered | from | to |
|---|---------------------------------------|------|----|
| Jennie Webster Boazville, Ms. (mailing address) | | | |
| WELL LOCATION: sec. 31 T 4 N R 6 E 2 miles west of Boazville (distance) (direction) (nearest town) | | | |
| WELL PURPOSE: (home, irrigation, municipal, industrial) | | | |
| WELL COMPLETION DATA: | | | |
| (1) diameter (inches) 4 | | | |
| (2) total depth (feet) 160 | | | |
| (3) static water level (feet) 80 below top of ground. | | | |
| (4) casing (material) Plastic, (depth) 160 | | | |
| (size) If telescope see back. | | | |
| (5) screen (length) 10, (depth to top) 150 | | | |
| (size) 4, (material) plastic | | | |
| (6) pump (HP) 1/3, (yield gpm) 10 | | | |
| (type power) E. line | | | |
| (7) electric log (yes or no) no | | | |
| (organization running log) | | | |
| (8) how well bottom plugged plugged | | | |
| DRILLERS REMARKS: | | | |

RECEIVED
 FEB 23 1976

If well telescopes please sketch and show depths.

GROUND LEVEL

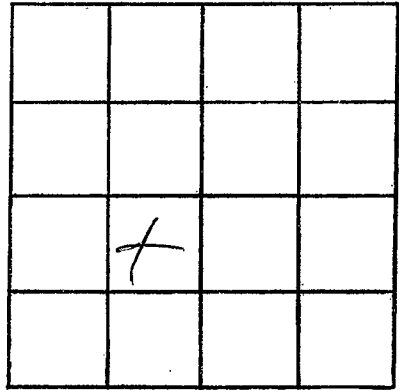

SECTION _____

Please indicate well location X.

ADDITIONAL INFORMATION

If more than one screen,
show locations of each on sketch.