

Date
 C 2018
 2-24-76

MISSISSIPPI
 BOARD OF WATER COMMISSIONERS
 416 North State Street
 Jackson, Mississippi 39201

WATER WELL DRILLERS LOG

2-24-76 ^{15E} W.A. Mason Water Well Contr. Jato
 date well completed firm name county well located

LANDOWNER:	description of formations encountered	from	to
<u>Ben Myers</u>	<u>clay lens</u>	<u>10</u>	<u>6</u>
<u>RFD - Coldwater Miss</u> (mailing address)	<u>gravel</u>	<u>6</u>	<u>40</u>
WELL LOCATION: sec <u>4</u> T <u>4</u> N R <u>6</u> E <u>5 1/2</u> miles <u>NW</u> of <u>Water Well</u> (distance) (direction) (nearest town)	<u>white sand</u>	<u>10</u>	<u>164</u>

WELL PURPOSE: Home
 (home, irrigation, municipal, industrial)

- WELL COMPLETION DATA:
- (1) diameter (inches) 4"
 - (2) total depth (feet) 164'
 - (3) static water level (feet) 103' ^{below} / _{above} top of ground.
 - (4) casing Pvc Plastic 154'
 (material) (depth)
4'
 (size) if telescope see back.
 - (5) screen 10', 154'
 (length) (depth to top)
2", Pvc Plastic
 (size) (material)
 - (6) pump 1/2 10
 (HP) (yield gpm)
electric
 (type power)
 - (7) electric log No
 (yes or no)

(organization running log)
 (8) how well bottom plugged Gap on screen


DRILLERS REMARKS:

RECEIVED
 JUN 28 1976

MISS. BD. OF WATER COM.

If well telescopes please sketch and show depths.

GROUND LEVEL

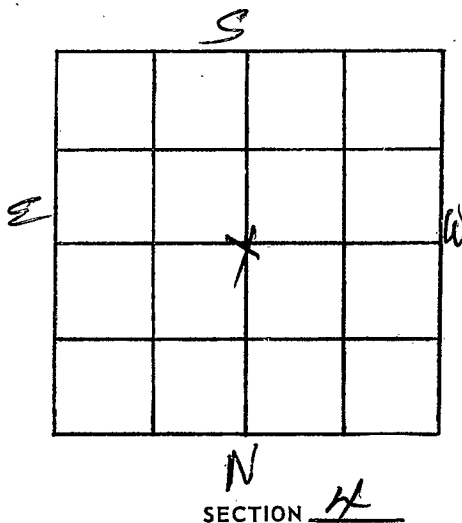

Please indicate well location X.

ADDITIONAL INFORMATION

If more than one screen, show locations of each on sketch.