

Tate  
C 2020  
3-29-76

MISSISSIPPI  
BOARD OF WATER COMMISSIONERS  
416 North State Street  
Jackson, Mississippi 39201

WATER WELL DRILLERS LOG

3-29-1976 <sup>W.A. Mason</sup> Water Well Driller's name: W.A. Mason <sup>Jate</sup> county well located

LANDOWNER:  
Avis Embrey  
RFD-Caldwater Miss  
(mailing address)

description of formations encountered	from	to
Clay silt	0	16
gravel	16	19
Red sand	19	40
White sand	40	127

WELL LOCATION:  
sec 14 T 4 N R 6 E  
1 1/2 miles West of North  
(distance) (direction) (nearest town)

WELL PURPOSE: Home  
(home, irrigation, municipal, industrial)

- WELL COMPLETION DATA:
- (1) diameter (inches) 4 1/2"
  - (2) total depth (feet) 122'
  - (3) static water level (feet) 55' <sup>below</sup> ~~above~~ top of ground.
  - (4) casing PVC Plastic 1 1/2'  
(material) (depth)  
4 1/2" if telescope see back.  
(size)
  - (5) screen 10' 112'  
(length) (depth to top)  
4 1/2" PVC Plastic  
(size) (material)
  - (6) pump 3/4 12  
(HP) (yield gpm)
  - Electric  
(type power)
  - (7) electric log No  
(yes or no)
- (organization running log)

(8) how well bottom plugged  
Complete screen


DRILLERS REMARKS:

RECEIVED  
MAY 28 1976

MISS. Bd. OF WATER COMMISSIONERS

If well telescopes please sketch and show depths.

GROUND LEVEL

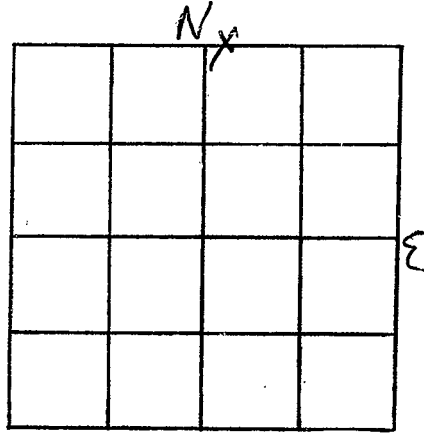

SECTION 14

Please indicate well location X.

ADDITIONAL INFORMATION

If more than one screen, show locations of each on sketch.