

Late
C 2001
4-28-76

MISSISSIPPI
 BOARD OF WATER COMMISSIONERS
 416 North State Street
 Jackson, Mississippi 39201

WATER WELL DRILLERS LOG

4-28 1976 Harris Bros. Late
 date well completed firm name county well located

LANDOWNER: Mt. Zion Baptist Church
Independence
 (mailing address)

description of formations encountered	from	to
<u>top soil</u>	<u>0</u>	<u>20</u>
<u>clay + sand</u>	<u>20</u>	<u>25</u>
<u>coarse sand</u>	<u>25</u>	<u>100</u>

WELL LOCATION:
 sec. 35 T 4 N R 6 E
0 miles Independence
 (distance) (direction) (nearest town)

WELL PURPOSE: home
 (home, irrigation, municipal, industrial)

WELL COMPLETION DATA:

(1) diameter (inches) 4

(2) total depth (feet) 100

(3) static water level (feet) 60 below above top of ground.

(4) casing Plastic, 93
 (material) (depth)
4 If telescope see back.
 (size)

(5) screen 7, 93
 (length) (depth to top)
008, Plastic
 (size) (material)

(6) pump 3/4, 7
 (HP) (yield gpm)
elec.
 (type power)

(7) electric log no
 (yes or no)

(organization running log)

(8) how well bottom plugged solid


DRILLERS REMARKS:

RECEIVED
 OCT 22 1976

MISS. BD. OF WATER COMMISSIONERS

If well telescopes please sketch and show depths.

GROUND LEVEL

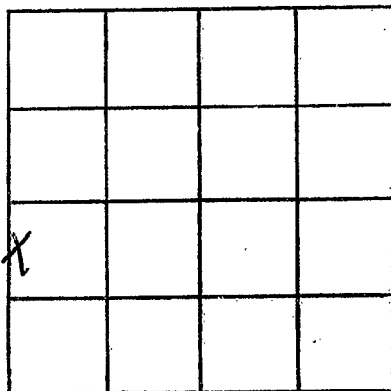

SECTION 35

Please indicate well location X.

ADDITIONAL INFORMATION

If more than one screen, show locations of each on sketch.