

Tate
C 2005
6-9-76

MISSISSIPPI
 BOARD OF WATER COMMISSIONERS
 416 North State Street
 15E Jackson, Mississippi 39201


WATER WELL DRILLERS LOG

6-9 1976 Hicks Well Co. Tate
 date well completed firm name county well located

LANDOWNER: <u>Floyd Brown</u> <u>Rt. 2</u>	description of formations encountered	from	to
<u>Caldwater, Miss.</u> (mailing address)	<u>Red Clay</u>	<u>0</u>	<u>10</u>
WELL LOCATION: sec. <u>32</u> <u>4</u> N R <u>6</u> E <u>6</u> miles <u>E</u> of <u>Caldwater</u> (distance) (direction) (nearest town)	<u>Red Sand</u>	<u>10</u>	<u>60</u>
WELL PURPOSE: <u>Home</u> (home, irrigation, municipal, industrial)	<u>White Clay</u>	<u>60</u>	<u>100</u>
WELL COMPLETION DATA: (1) diameter (inches) <u>4"</u>	<u>White Sand</u>	<u>100</u>	<u>135</u>
(2) total depth (feet) <u>135</u>			
(3) static water level (feet) <u>80</u> below above top of ground.			
(4) casing <u>PVC</u> , <u>135</u> (material) (depth)			
(5) screen <u>41</u> , <u>131</u> (length) (depth to top)			
(6) pump <u>1/2</u> , <u>10</u> (HP) (yield gpm)			
<u>220</u> (type power)			
(7) electric log <u>NO</u> (yes or no)			
(8) how well bottom plugged <u>Cap</u>			
DRILLERS REMARKS:			

If well telescopes please sketch and show depths.

GROUND LEVEL

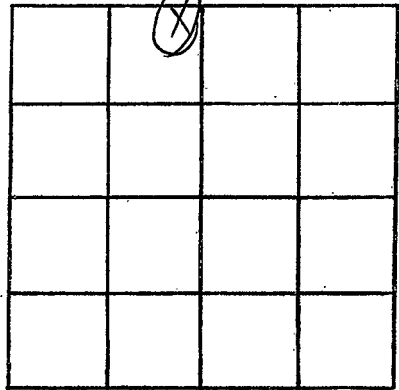

SECTION 32

Please indicate well location X.

ADDITIONAL INFORMATION

If more than one screen,
show locations of each on sketch.