

MISSISSIPPI
BOARD OF WATER COMMISSIONERS
416 North State Street
Jackson, Mississippi 39201

WATER WELL DRILLERS LOG

Date
C 2000
6-15-76

6-15 date well completed 1976 Harris Bros firm name Tate county well located

LANDOWNER: Greg Flippen
At. 4
Coldwater
(mailing address)

description of formations encountered	from	to
top soil	0	20
clay + sand	20	100
coarse sand	100	120

WELL LOCATION:
sec. 34 T. 4 N. R. 6 E.
2 miles SW of Independence
(distance) (direction) (nearest town)

WELL PURPOSE: home
(home, irrigation, municipal, industrial)

- WELL COMPLETION DATA:
- (1) diameter (inches) 4
 - (2) total depth (feet) 120
 - (3) static water level (feet) 90 below above top of ground.
 - (4) casing Plastic 113
(material) (depth)
4 if telescope see back.
(size)
 - (5) screen 7 113
(length) (depth to top)
100 Plastic
(size) (material)
 - (6) pump 3/4 7
(HP) (yield gpm)
elec
(type power)
 - (7) electric log no
(yes or no)
(organization running log)
 - (8) how well bottom plugged solid

DRILLERS REMARKS:


RECEIVED

OCT 22 1976

MISS. BD. OF WATER COMMISSIONERS

If well telescopes please sketch and show depths.

GROUND LEVEL

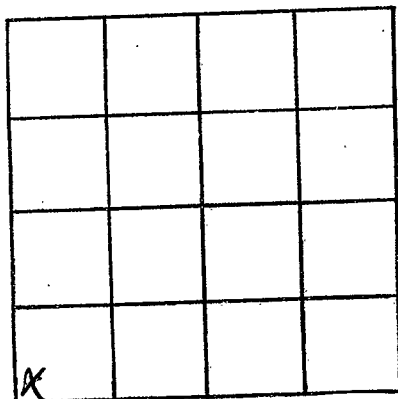

SECTION 34

Please indicate well location X.

ADDITIONAL INFORMATION

If more than one screen, show locations of each on sketch.