

Date  
 6-20-76

MISSISSIPPI  
 BOARD OF WATER COMMISSIONERS  
 416 North State Street  
 Jackson, Mississippi 39201

WATER WELL DRILLERS LOG

6-20-76 19 W.A. Mason, Water Well South date well completed firm name Jato county well located


LANDOWNER:	description of formations encountered	from	to
W. L. Mayer	Clay Lint	90	12
RFD. Colwater, Miss. (mailing address)	Red sand	12	45
WELL LOCATION: sec. 18 T. 4 N. R. 6 E. 6 3/4 miles SW of J.W. Field (distance) (direction) (nearest town)	white sand	45	110
WELL PURPOSE: Home (home, irrigation, municipal, industrial)			
WELL COMPLETION DATA:			
(1) diameter (inches) 4"			
(2) total depth (feet) 105'			
(3) static water level (feet) 45' below top of ground			
(4) casing Plastic 95' (material) (depth)			
4" If telescope see back. (size)			
(5) screen 10' 95' (length) (depth to top)			
4" Plastic (size) (material)			
(6) pump 3/4 10 (HP) (yield gpm)			
e certain (type power)			
(7) electric log No (yes or no)			
(organization running log)			
(8) how well bottom plugged Cap			
DRILLERS REMARKS:			

RECEIVED  
 JUL 7 1977

MISS. BD. OF WATER COMMISSIONERS

If well telescopes please sketch and show depths.

GROUND LEVEL

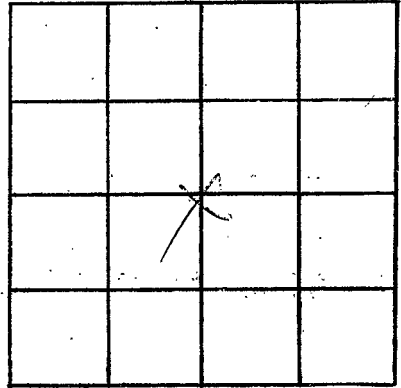

Please indicate well location X.

ADDITIONAL INFORMATION

If more than one screen, show locations of each on sketch.