

Date  
C 2028  
8-5-76

MISSISSIPPI  
 BOARD OF WATER COMMISSIONERS  
 416 North State Street  
 15E Jackson, Mississippi 39201

WATER WELL DRILLERS LOG

8-5 19 76 Hick Well Co. Tate  
 date well completed firm name county well located

LANDOWNER: <u>Franklin Corn</u>	description of formations encountered	from	to
<u>Independence, Miss</u> (mailing address)	<u>Red Clay</u> <u>White Clay Sand</u> <u>White Sand</u>	<u>0</u> <u>20</u> <u>80</u>	<u>20</u> <u>80</u> <u>125</u>
WELL LOCATION: sec <u>26</u> T <u>4</u> N R <u>6</u> E <u>1/2</u> miles <u>E</u> of <u>Independence</u> (distance) (direction) (nearest town)			
WELL PURPOSE: <u>Home</u> (home, irrigation, municipal, industrial)			
WELL COMPLETION DATA:			
(1) diameter (inches) <u>4"</u>			
(2) total depth (feet) <u>125</u>			
(3) static water level (feet) <u>70</u> below above top of ground.			
(4) casing <u>PVC</u> , <u>125</u> (material) (depth)			
(size) if telescope see back.			
(5) screen <u>7</u> , <u>118</u> (length) (depth to top)			
(size) <u>4"</u> , <u>gravel</u> (material)			
(6) pump <u>3/4</u> , <u>10 gal.</u> (HP) (yield gpm)			
<u>220V</u> (type power)			
(7) electric log <u>NO</u> (yes or no)			
(organization running log)			
(8) how well bottom plugged. <u>Cap</u>			
DRILLERS REMARKS:			


**RECEIVED**

AUG 26 1976

MISS. BD. OF WATER COMMISSIONERS

If well telescopes please sketch and show depths.

GROUND LEVEL

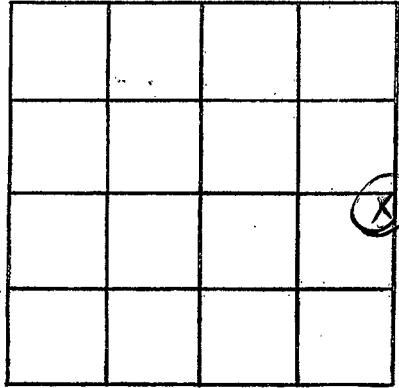

SECTION 26

Please indicate well location X.

ADDITIONAL INFORMATION

If more than one screen,  
show locations of each on sketch.