

Tate  
C 2030  
1-21-77

MISSISSIPPI  
BOARD OF WATER COMMISSIONERS  
416 North State Street  
15E Jackson, Mississippi 39201

WATER WELL DRILLERS LOG

1-21 1977 Hicks Well Co Tate  
date well completed firm name county well located

LANDOWNER: Mrs. Rodney Momey  
B.H.

Coldwater, Miss.  
(mailing address)

WELL LOCATION: NW 1/4 SE  
sec. 6 T. 4 N R. 6 E  
3 miles W of Trunkline Pumping Station  
(distance) (direction) (nearest town)

WELL PURPOSE: none  
(home, irrigation, municipal, industrial)

WELL COMPLETION DATA:  
(1) diameter (inches) 4"  
(2) total depth (feet) 160  
(3) static water level (feet) 80 below top of ground.  
(4) casing PVC 160 (material) (depth)  
(size) If telescope see back.  
(5) screen 7ft 153 (length) (depth to top)  
4" Shovel Type (size) (material)  
(6) pump 1/2 10 (HP) (yield gpm)  
2201 (type power)  
(7) electric log No (yes or no)  
(organization running log)  
(8) how well bottom plugged Cap


description of formations encountered	depths	
	from	to
Red clay	0	20
Red sand	20	90
White clay	90	130
White sand	130	160

RECEIVED  
FEB 24 1977  
MISS. Bd. OF WATER COMMISSIONERS

DRILLERS REMARKS:

If well telescopes please sketch and show depths.

GROUND LEVEL

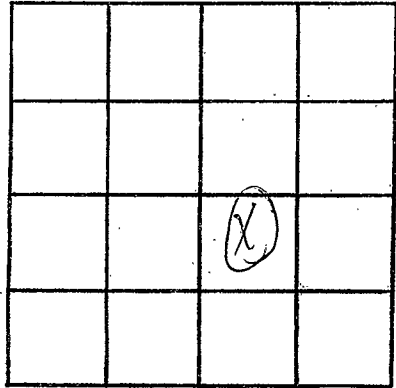

SECTION 6

Please indicate well location X.

ADDITIONAL INFORMATION

If more than one screen,  
show locations of each on sketch.