

**MISSISSIPPI
BOARD OF WATER COMMISSIONERS**
416 North State Street
15E Jackson, Mississippi 39201

WATER WELL DRILLERS LOG

Date
C 2031
5-14-77

5-14 1977 Harris Bros Lato
 date well completed firm name county well located

LANDOWNER M. L. Stanning
Rt. 3 Box 354
Coldwater
 (mailing address)

description of formations encountered	from	to
<u>top soil</u>	<u>0</u>	<u>20</u>
<u>Clay & fine sand</u>	<u>20</u>	<u>25</u>
<u>Coarse sand</u>	<u>25</u>	<u>100</u>

WELL LOCATION:
 sec 27 T 4 N R 6 E
3/4 miles W of Independence
 (distance) (direction) (nearest town)

WELL PURPOSE: home
 (home, irrigation, municipal, industrial)

WELL COMPLETION DATA:

(1) diameter (inches) 4

(2) total depth (feet) 100

(3) static water level (feet) 60 below top of ground. above

(4) casing Plastic, 93'
 (material) (depth)
4" if telescope see back.
 (size)

(5) screen 7' 93'
 (length) (depth to top)
008 Plastic
 (size) (material)

(6) pump 3/4 10
 (HP) (yield gpm)
elec
 (type power)

(7) electric log no
 (yes or no)
 (organization running log)


(8) how well bottom plugged solid

DRILLERS REMARKS:

RECEIVED
 SEP 30 1977

If well telescopes please sketch and show depths.

GROUND LEVEL

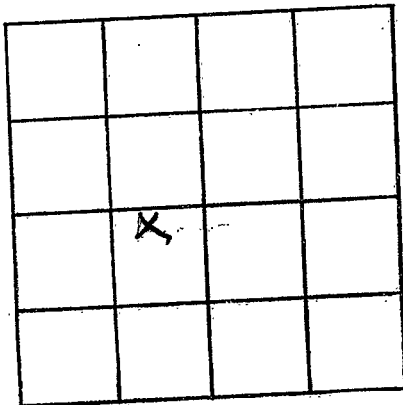

SECTION 27

Please indicate well location X.

ADDITIONAL INFORMATION

If more than one screen, show locations of each on sketch.