

Tate
 C 2032
 S-21-77

MISSISSIPPI
 BOARD OF WATER COMMISSIONERS
 416 North State Street
 156 Jackson, Mississippi 39201

WATER WELL DRILLERS LOG

5-21 1977 date well completed
 Harris Bros. firm name
 Tate county well located

LANDOWNER Jimmy Ineed

description of formations encountered

from to

Rt. 3
 Coldwater
 (mailing address)

top soil 0 20
 white clay + sand 20 100
 coarse sand 100 120

WELL LOCATION:

sec. 18 T. 4 N R. 6 E
 1 1/2 miles W of Surline
 (distance) (direction) (nearest town)

WELL PURPOSE: home
 (home, irrigation, municipal, industrial)

WELL COMPLETION DATA:

- (1) diameter (inches) 4
- (2) total depth (feet) 120
- (3) static water level (feet) 30 below top of ground.
- (4) casing Plastic, 113' (material) (depth)
 4 (size) if telescope see back.
- (5) screen 7' 113' (length) (depth to top)
 008, Plastic (size) (material)
- (6) pump 3/4 7 (HP) (yield gpm)
 elec. (type power)
- (7) electric log no (yes or no)

(organization running log)

(8) how well bottom plugged solid


DRILLERS REMARKS:

RECEIVED
 SEP 30 1977

MISS. BD OF WATER COMMISSIONERS

If well telescopes please
sketch and show depths.

GROUND LEVEL

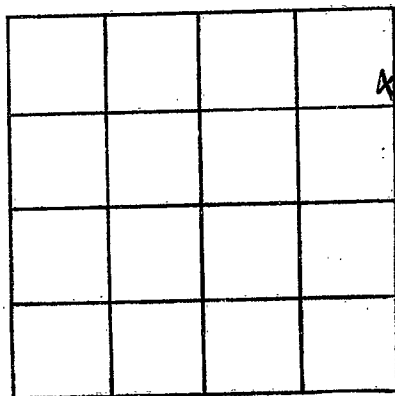

SECTION 18

Please indicate well location X.

ADDITIONAL INFORMATION

If more than one screen,
show locations of each on sketch.