

Tate
 C 2033
 5-31-77

MISSISSIPPI
 BOARD OF WATER COMMISSIONERS
 416 North State Street
 156 Jackson, Mississippi 39201

WATER WELL DRILLERS LOG

5-31-77 date well completed Hike Well Co firm name Tate county well located

LANDOWNER: Severn Poyos
Rt. 3
Coldwater, Ms.
 (mailing address)

description of formations encountered	from	to
Red clay	0	40
Red sand	40	90
White sand	90	150
Star Station		

WELL LOCATION:
 sec. 8 T-4 N R-6 E
3 miles W of Trunklin
 (distance) (direction) (nearest town)
ALMOST AT LURLINE

WELL PURPOSE: Home
 (home, irrigation, municipal, industrial)

- WELL COMPLETION DATA:
- (1) diameter (inches) 4"
 - (2) total depth (feet) 150
 - (3) static water level (feet) 80 below above top of ground.
 - (4) casing PVC, 150,
 (material) (depth)
 (size) if telescope see back.
 - (5) screen 7', 743
 (length) (depth to top)
4", gravel type
 (size) (material)
 - (6) pump 1/2, 10
 (HP) (yield gpm)
220V
 (type power)
 - (7) electric log No
 (yes or no)


(organization running log)
 (8) how well bottom plugged Cap

DRILLERS REMARKS:

RECEIVED
 JUL 13 1977
 MISS. BD. OF WATER COMMISSIONERS

If well telescopes please sketch and show depths.

GROUND LEVEL

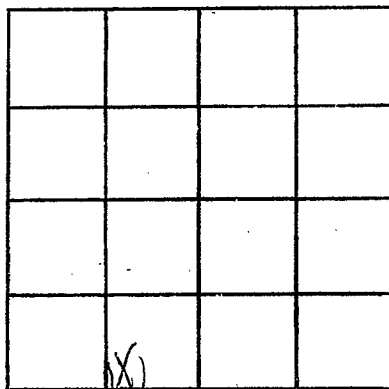

SECTION 8

Please indicate well location X.

ADDITIONAL INFORMATION

If more than one screen, show locations of each on sketch.