

TATE  
 C 2035  
 9-11-77

MISSISSIPPI  
 BOARD OF WATER COMMISSIONERS  
 416 North State Street  
 Jackson, Mississippi 39201

WATER WELL DRILLERS LOG

9-11 date well completed 1977 Harris Bros firm name Tate county well located

LANDOWNER: Rodney Wilson  
 Rt. 3  
 Coldwater  
 (mailing address)

| Description of formations encountered | from | to  |
|---------------------------------------|------|-----|
| top soil                              | 0    | 15  |
| gravel                                | 15   | 25  |
| clay + sand                           | 25   | 125 |
| coarse sand                           | 125  | 140 |

WELL LOCATION:  
 sec. 21 T. 4 N R. 6 E  
 2 1/2 miles NW of Independence  
 (distance) (direction) (nearest town)

WELL PURPOSE: home  
 (home, irrigation, municipal, industrial)

- WELL COMPLETION DATA:
- (1) diameter (inches) 4
  - (2) total depth (feet) 140
  - (3) static water level (feet) 80 <sup>below</sup> ~~above~~ top of ground.
  - (4) casing Plastic, 133 (material) (depth)  
 #4 (size) if telescope see back.
  - (5) screen 7, 133 (length) (depth to top)  
 #008 Plastic (size) (material)
  - (6) pump 3/4, 10 (HP) (yield gpm)  
 elec. (type power)
  - (7) electric log no (yes or no)  
 (organization running log)
  - (8) how well bottom plugged solid


**RECEIVED**  
 SEP 20 1977

DRILLERS REMARKS:

MISS. BB. OF WATER COMMISSIONERS

If well telescopes please sketch and show depths.

GROUND LEVEL

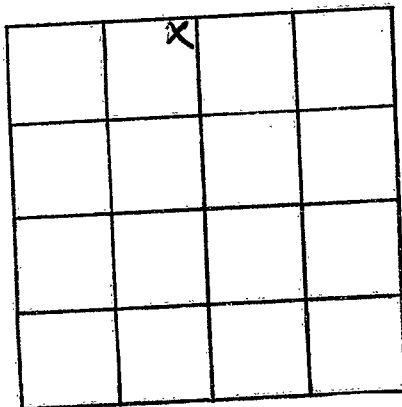

SECTION 21

Please indicate well location X.

ADDITIONAL INFORMATION

If more than one screen, show locations of each on sketch.