

Tate
 B 2032
 10/31/77

MISSISSIPPI
 BOARD OF WATER COMMISSIONERS
 416 North State Street
 Jackson, Mississippi 39201

WATER WELL DRILLERS LOG

10/31/77 date well completed Hicks Well Co firm name Tate county well located

LANDOWNER: Bob Darnell
 Rt. 2
 Coldwater, Ms.
 (mailing address)

description of formations encountered	from	to
Red clay	0	15
Red clay + sand	15	40
White sand	40	82

WELL LOCATION:
 sec. 11 T. 4 N. R. 6 E.
 4 miles N of Independence
 (distance) (direction) (nearest town)

description of formations encountered	from	to
Red clay	0	15
Red clay + sand	15	40
White sand	40	82

WELL PURPOSE: Home
 (home, irrigation, municipal, industrial)

description of formations encountered	from	to
Red clay	0	15
Red clay + sand	15	40
White sand	40	82

WELL COMPLETION DATA:
 (1) diameter (inches) 4
 (2) total depth (feet) 82
 (3) static water level (feet) 35 below top of ground.
 (4) casing PVC 82 (material) (depth)
 (size) if telescope see back.
 (5) screen 7' 75" (length) (depth to top)
 4" gravel type (size) (material)
 (6) pump 42 10 (HP) (yield gpm)
 220V (type power)
 (7) electric log No (yes or no)
 (organization running log)
 (8) how well bottom plugged Cap


description of formations encountered	from	to
Red clay	0	15
Red clay + sand	15	40
White sand	40	82

DRILLERS REMARKS:

RECEIVED
 NOV 22 1977
 MISS. BD. OF WATER COMMISSIONERS

If well telescopes please sketch and show depths.

GROUND LEVEL

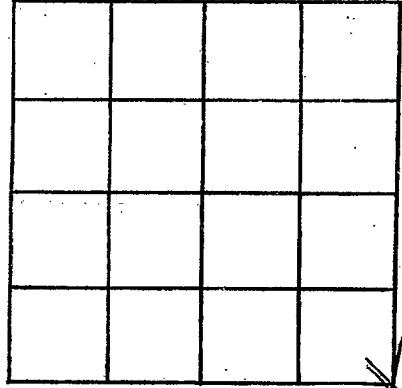

SECTION 11

Please indicate well location X.

ADDITIONAL INFORMATION

If more than one screen, show locations of each on sketch.