

Tate
 C 2051
 11/2/77

MISSISSIPPI
 BOARD OF WATER COMMISSIONERS
 416 North State Street
 Jackson, Mississippi 39201

WATER WELL DRILLERS LOG

11/2 1977 Hirsch Well Co. Tate
 date well completed firm name county well located

LANDOWNER: Edward S. George
 Rt. 3
 Coldwater, Ms.
 (mailing address)

description of formations encountered	from	to
Sand + gravel	0	90
white sand	90	133

WELL LOCATION:
 sec. 5 T. 4 N. R. 6 E. NW NE
 7 miles N of Independence
 (distance) (direction) (nearest town)

WELL PURPOSE: home
 (home, irrigation, municipal, industrial)


WELL COMPLETION DATA:
 (1) diameter (inches) 4
 (2) total depth (feet) 133
 (3) static water level (feet) 90 below top of ground.
 (4) casing PVC, 133, (material) (depth)
 (size) if telescope see back.
 (5) screen 7' 126 (length) (depth to top)
 4" gravel type (size) (material)
 (6) pump 1/2 15 (HP) (yield gpm).
 220V (type power)
 (7) electric log No (yes or no)
 (organization running log)
 (8) how well bottom plugged Cap

DRILLERS REMARKS:

RECEIVED
 NOV 22 1977

If well telescopes please sketch and show depths.

GROUND LEVEL

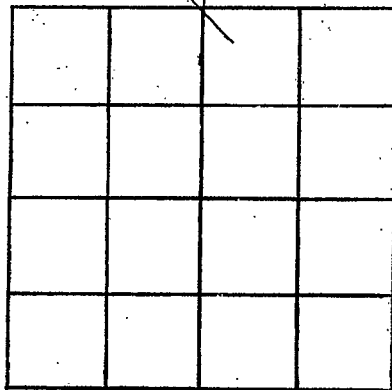

SECTION 13

Please indicate well location X.

ADDITIONAL INFORMATION

If more than one screen, show locations of each on sketch.