

Tate
 C 2038
 11/14/77

MISSISSIPPI
 BOARD OF WATER COMMISSIONERS
 416 North State Street
 Jackson, Mississippi 39201

WATER WELL DRILLERS LOG

11-14 1977 Kicks Well Co. Tate
 date well completed firm name county well located

LANDOWNER: Kenneth Odum
 Rt. 3,
 Coldwater, Ms.
 (mailing address)

description of formations encountered	from	to
Red clay	0	30
Red sand	30	45
Red sand + small rock	45	90
white sand	90	120

WELL LOCATION:
 sec. 1 T 4 N R 6 E
 2 miles N of Woodfield
 (distance) (direction) (nearest town)

WELL PURPOSE: home
 (home, irrigation, municipal, industrial)

WELL COMPLETION DATA:
 (1) diameter (inches) 4
 (2) total depth (feet) 120
 (3) static water level (feet) 200 below top of ground.
 (4) casing PVC, 120 (material), (depth)
 (size) if telescope see back.
 (5) screen 7' (length), 113' (depth to top)
 4' (size), gravel type (material)
 (6) pump 1/2 (HP), 10 (yield gpm)
 220V (type power)
 (7) electric log No (yes or no)
 (organization running log)
 (8) how well bottom plugged Cap


DRILLERS REMARKS:

RECEIVED
 DEC 13 1977

MISS. BD. OF WATER COMM

If well telescopes please sketch and show depths.

GROUND LEVEL

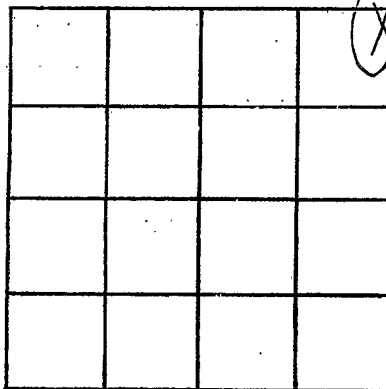

SECTION 1

Please indicate well location X.

ADDITIONAL INFORMATION

If more than one screen, show locations of each on sketch.