

TATE
C 2037

**MISSISSIPPI
BOARD OF WATER COMMISSIONERS**
416 North State Street
Jackson, Mississippi 39201

WATER WELL DRILLERS LOG

Date

5-5-77 Bob Anell Well Service

date well completed firm name county well located

LANDOWNER:
Jane Dunning
Harold, ms.
(mailing address)

description of formations encountered	from	to
<i>top soil</i>	<i>0</i>	<i>5</i>
<i>red clay</i>	<i>5</i>	<i>30</i>
<i>sand & clay</i>	<i>30</i>	<i>100</i>
<i>sand</i>	<i>100</i>	<i>140</i>

WELL LOCATION:
4 ⁶ T 4 N R 6 ^{NESE} E
0 0 0 *Delaware*
miles of (distance) (direction) (nearest town)

WELL PURPOSE:
(home, irrigation, municipal, industrial)

WELL COMPLETION DATA:

(1) diameter (inches) 4"

(2) total depth (feet) 140

(3) static water level (feet) 60 below/above top of ground.

(4) casing plastic, 140
(material) (depth)

(size) if telescope see back.

(5) screen 10, 130
(length) (depth to top)

4", plastic
(size) (material)

(6) pump 3/4, 10
(HP) (yield gpm)

E lee
(type power)

(7) electric log (yes or no) (no)

(organization running log)

(8) how well bottom plugged (circled)

RECEIVED


MAY 30 1978

DRILLERS REMARKS:

MISS. BY. OF WATER DRINK

If well telescopes please sketch and show depths.

GROUND LEVEL

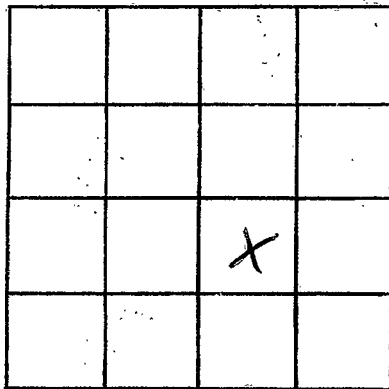

SECTION _____

Please indicate well location X.

ADDITIONAL INFORMATION

If more than one screen,
show locations of each on sketch.