

Tate  
 C 2040  
 11/23/77

MISSISSIPPI  
 BOARD OF WATER COMMISSIONERS  
 416 North State Street  
 Jackson, Mississippi 39201

WATER WELL DRILLERS LOG

11/23/77 date well completed  
 77 Hacks Well Co. firm name  
 Tate county well located

LANDOWNER: Kenny Ray  
Rt. 4  
Caldewater, Mo.  
 (mailing address)

description of formations encountered	from	to
Red clay	0	15
Red clay + Sand	15	40
White clay + Sand	40	90
White sand	90	110
White clay + Sand	110	145
White sand	145	165

WELL LOCATION:  
 sec. 33 T 4 N R. 6 E  
1 miles (distance) E of Pouquillon (direction) (nearest town)

WELL PURPOSE: Home  
 (home, irrigation, municipal, industrial)

WELL COMPLETION DATA:  
 (1) diameter (inches) 4  
 (2) total depth (feet) 165  
 (3) static water level (feet) 80 below top of ground.  
 (4) casing PVC (material), 165 (depth)  
 (size) if telescope see back.  
 (5) screen 7' (length), 158' (depth to top)  
4" gravel type (size) (material)  
 (6) pump 1/2 (HP), 10 (yield gpm)  
220 V (type power)  
 (7) electric log No (yes or no)

(organization running log)  
 (8) how well bottom plugged Cup

DRILLERS REMARKS:


RECEIVED

NOV 30 1977

MISS. BD. OF WATER COMM

If well telescopes please sketch and show depths.

GROUND LEVEL

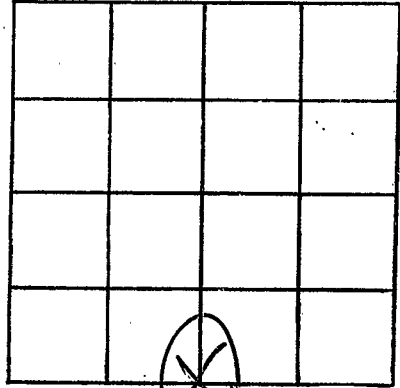

SECTION

33

Please indicate well location X.

ADDITIONAL INFORMATION

If more than one screen, show locations of each on sketch.