

TATE
C 2043

**MISSISSIPPI  
BOARD OF WATER COMMISSIONERS**  
416 North State Street  
Jackson, Mississippi 39201

**WATER WELL DRILLERS LOG**

6-23-19 78 Hicks Well Co. Natchez  
 date well completed                      firm name                      county well located


LANDOWNER: <i>Charles Embury</i>	description of formations encountered	from	to
<i>Box 3</i>			
<i>Caldwater Ms.</i> (mailing address)	<i>Red Clay</i>	<i>0</i>	<i>10</i>
WELL LOCATION: sec. <i>8</i> T. <i>4</i> N. <i>3</i> R. <i>6</i> E. <i>?</i> <i>W</i> _____ miles _____ of <i>Greenleaf</i> (distance) (direction) (nearest town)	<i>White Clay &amp; Sand</i>	<i>10</i>	<i>80</i>
WELL PURPOSE: <i>Home</i> (home, irrigation, municipal, industrial)	<i>White Sand</i>	<i>80</i>	<i>140</i>
WELL COMPLETION DATA: (1) diameter (inches) <i>4</i>			
(2) total depth (feet) <i>140</i>			
(3) static water level (feet) <i>80</i> below top of ground.			
(4) casing <i>PVC</i> , <i>140</i> (material) (depth)			
_____ if telescope see back. (size)			
(5) screen <i>7</i> , <i>133</i> (length) (depth to top)			
<i>4</i> , <i>gunmetal tape</i> (size) (material)			
(6) pump <i>1/2</i> , <i>10</i> (HP) (yield gpm)			
<i>220V</i> (type power)			
(7) electric log <i>No</i> (yes or no)			
_____ (organization running log)			
(8) how well bottom plugged <i>Cap</i>			

DRILLERS REMARKS: \_\_\_\_\_

**RECEIVED**  
JUN 29 1978  
MISS. BD. OF WATER COMMISSIONERS

If well telescopes please sketch and show depths.

GROUND LEVEL

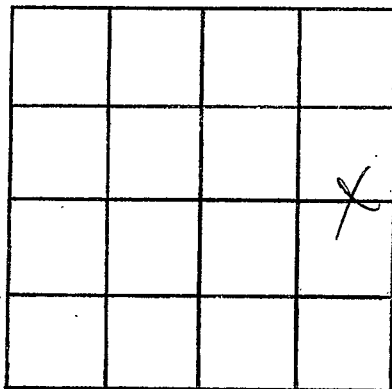

SECTION 8

Please indicate well location X.

ADDITIONAL INFORMATION

If more than one screen,  
show locations of each on sketch.