

TATE
C <i>2044</i>
4-7-78

**MISSISSIPPI
BOARD OF WATER COMMISSIONERS**
416 North State Street
Jackson, Mississippi 39201

WATER WELL DRILLERS LOG

4-7-78 Bob Smith Well Dr. Jate
 date well completed firm name county well located

LANDOWNER:
Wm. Smith
C. Edwards, Jr.
 (mailing address)

description of formations encountered	depth	
	from	to
<u>Top 3' soil</u>	<u>0</u>	<u>5</u>
<u>red clay</u>	<u>50</u>	<u>60</u>
<u>gravel</u>	<u>60</u>	<u>70</u>
<u>sand</u>	<u>70</u>	<u>200</u>

WELL LOCATION:
 sec. 15 T. 5 N. R. 6 E.
3 miles 2 N of Ind.
 (distance) (direction) (nearest town)

WELL PURPOSE:
 (home, irrigation, municipal, industrial)

WELL COMPLETION DATA:

(1) diameter (inches) 4"

(2) total depth (feet) 200

(3) static water level (feet) 90 below above top of ground.

(4) casing plastic, 200
 (material) (depth)

_____ if telescope see back.
 (size)

(5) screen 20 180
 (length) (depth to top)

4"
 (size) plastic
 (material)

(6) pump 3/4 10
 (HP) (yield gpm)

Elec
 (type power)

(7) electric log (yes or no) no

 (organization running log)

(8) how well bottom plugged


DRILLERS REMARKS:

RECEIVED
 NOV 27 1978

MISS. BD. OF WATER COMM.

If well telescopes please sketch and show depths.

GROUND LEVEL

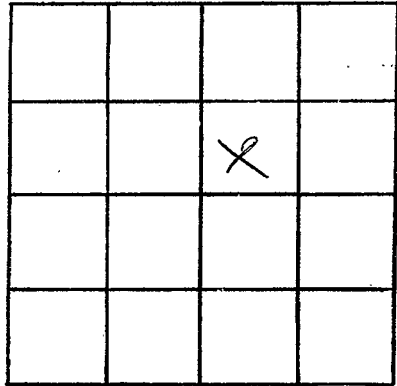

SECTION _____

Please indicate well location X.

ADDITIONAL INFORMATION

If more than one screen, show locations of each on sketch.