

TATE
2045 ^C
10-20-78

**MISSISSIPPI
BOARD OF WATER COMMISSIONERS**
416 North State Street
Jackson, Mississippi 39201

WATER WELL DRILLERS LOG

10-20-1978 Hick Well Co Tate
 date well completed firm name county well located

LANDOWNER	description of formations encountered	from	to
<u>Elmore Beer</u> <u>Rt. 3, Box 131-H</u> <u>Hammonds</u> (mailing address)	<u>Red Clay Clay</u>	<u>0</u>	<u>15</u>
	<u>Red Sand</u>	<u>15</u>	<u>30</u>
WELL LOCATION: sec. <u>3</u> T. <u>4</u> N. R. <u>6</u> E. <u>3 1/2</u> miles <u>W</u> of <u>Wakefield</u> (distance) (direction) (nearest town)	<u>White Clay Sand</u>	<u>30</u>	<u>60</u>
	<u>White Sand + Clay</u>	<u>60</u>	<u>110</u>
WELL PURPOSE: <u>Home</u> (home, irrigation, municipal, industrial)	<u>White Sand</u>	<u>110</u>	<u>140</u>
WELL COMPLETION DATA:			
(1) diameter (inches) <u>4</u>			
(2) total depth (feet) <u>140</u>			
(3) static water level (feet) <u>80</u> below top of ground.			
(4) casing <u>PVC</u> , <u>140</u> (material), (depth)			
_____ if telescope see back. (size)			
(5) screen <u>7'</u> , <u>133</u> (length) (depth to top)			
<u>4"</u> , <u>concrete</u> (size) (material)			
(6) pump <u>1/2</u> , <u>10</u> (HP) (yield gpm)			
<u>200W</u> (type power)			
(7) electric log <u>No</u> (yes or no)			
_____ (organization running log)			
(8) how well bottom plugged <u>Cap</u>			
DRILLERS REMARKS:			


RECEIVED

OCT 30 1978

MISS. BD. OF WATER COMMISSIONERS

If well telescopes please sketch and show depths.

GROUND LEVEL

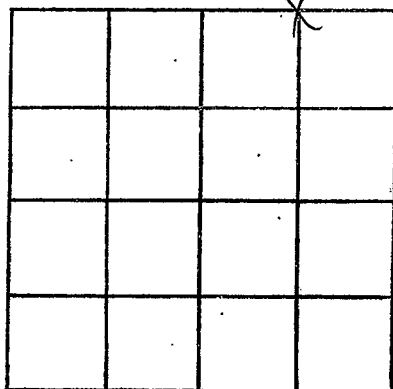

SECTION 3

Please indicate well location X.

ADDITIONAL INFORMATION

If more than one screen,
show locations of each on sketch.