

TATE
 C 2047
 8-24-78

MISSISSIPPI
 BOARD OF WATER COMMISSIONERS
 416 North State Street
 Jackson, Mississippi 39201

WATER WELL DRILLERS LOG

8-24-78 19 date well completed Bob Smith Wells firm name Tate county well located

LANDOWNER:
 Tommy Donnell
 Caldwell, ms
 (mailing address)

description of formations encountered	from	to
top soil	0	5
red clay	5	45
gravel	45	65
sand	65	180

WELL LOCATION:
 sec 13 T 4 N R 6 E
 3 miles E of Ind.
 (distance) (direction) (nearest town)

WELL PURPOSE:
 (home, irrigation, municipal, industrial)

WELL COMPLETION DATA:

(1) diameter (inches) 4 1/2

(2) total depth (feet) 180

(3) static water level (feet) 100 below top of ground

(4) casing (material) plastic (depth) 180
 (size) if telescope see back.

(5) screen 20 (length) 160 (depth to top)
 4 1/2 (size) plastic (material)

(6) pump 3/4 (HP) 10 (yield gpm)
 E.L. (type power)

(7) electric log (yes or no)

(organization running log)

(8) how well bottom plugged


DRILLERS REMARKS:

RECEIVED
 NOV 27 1978

MISSISSIPPI BOARD OF WATER COMMISSIONERS

If well telescopes please sketch and show depths.

GROUND LEVEL

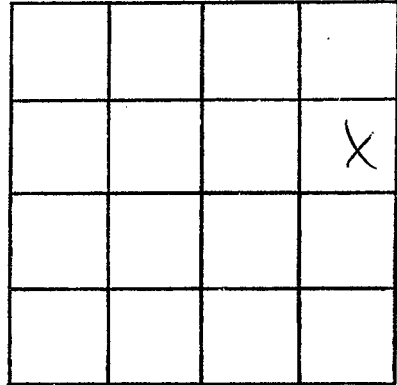

SECTION _____

Please indicate well location X.

ADDITIONAL INFORMATION

If more than one screen,
show locations of each on sketch.