

TATE
C 2079
1-16-79

**MISSISSIPPI
BOARD OF WATER COMMISSIONERS**
416 North State Street
Jackson, Mississippi 39201

WATER WELL DRILLERS LOG

1-16 1979 Hicks Well Co Tate
 date well completed firm name county well located

LANDOWNER: <u>Darnett West</u>	description of formations encountered	from	to
		<u>0</u>	<u>15</u>
<u>Independence, Ms.</u> (mailing address)	<u>Red Clay</u>		
	<u>Sand & Gravel</u>	<u>15</u>	<u>60</u>
	<u>white sand</u>	<u>60</u>	<u>110</u>

WELL LOCATION:
 sec. 22 T 4 N R. 6 E
1/2 miles N of Independence
 (distance) (direction) (nearest town)

WELL PURPOSE: Home
 (home, irrigation, municipal, industrial)

- WELL COMPLETION DATA:**
- (1) diameter (inches) 4
 - (2) total depth (feet) 110
 - (3) static water level (feet) 60 below top of ground.
 - (4) casing PVC, 110,
 (material) (depth)
 (size) if telescope see back.
 - (5) screen 7', 103
 (length) (depth to top)
4", gravel type
 (size) (material)
 - (6) pump 1/2, 10
 (HP) (yield gpm)
220V
 (type power)
 - (7) electric log No
 (yes or no)
 - (organization running log)
 - (8) how well bottom plugged Cap


DRILLERS REMARKS:

RECEIVED
 FEB 13-79

MISS. BD. OF WATER COMM

If well telescopes please sketch and show depths.

GROUND LEVEL

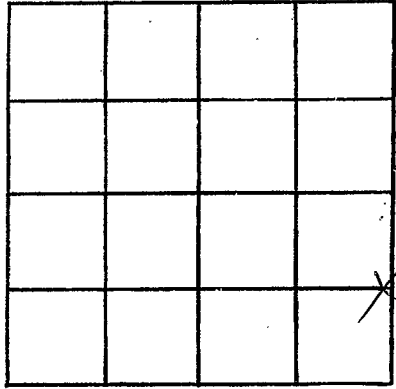

SECTION 22

Please indicate well location X.

ADDITIONAL INFORMATION

Lined area for additional information.

If more than one screen, show locations of each on sketch.