

Tate
C 2000
5-7-79

MISSISSIPPI
BOARD OF WATER COMMISSIONERS
416 North State Street
Jackson, Mississippi 39201

WATER WELL DRILLERS LOG


5-7 1979 Michs Well Co Tate
date well completed firm name county well located

LANDOWNER:	description of formations encountered	from	to
<u>Charles Bardo</u> <u>Rt. 3, Coldwater Miss.</u> (mailing address)	<u>Red Clay</u>	0	20
WELL LOCATION:	<u>Gravel</u>	20	60
sec. <u>3</u> T. <u>4</u> N. R. <u>6</u> E. <u>2</u> miles <u>N.W.</u> of <u>Pump Station</u> (distance) (direction) (nearest town)	<u>Red sand</u>	60	100
WELL PURPOSE: <u>home</u> (home; irrigation, municipal, industrial)	<u>white sand</u>	100	170
WELL COMPLETION DATA:			
(1) diameter (inches) <u>4 in</u>			
(2) total depth (feet) <u>170 ft</u>			
(3) static water level (feet) <u>80</u> below above top of ground.			
(4) casing <u>Plastic</u> <u>170</u> (material) (depth)			
(size) If telescope see back.			
(5) screen <u>7 ft</u> <u>163 ft</u> (length) (depth to top)			
<u>4 in</u> <u>Gravel</u> (size) (material)			
(6) pump <u>1/2</u> <u>10</u> (HP) (yield gpm)			
<u>220</u> (type power)			
(7) electric log <u>No</u> (yes or no)			
(organization running log)			
(8) how well bottom plugged <u>Cap</u>			
DRILLERS REMARKS:			

Miss. Board of Water Comm.
MAY 14 1979
RECEIVED

If well telescopes please sketch and show depths.

GROUND LEVEL

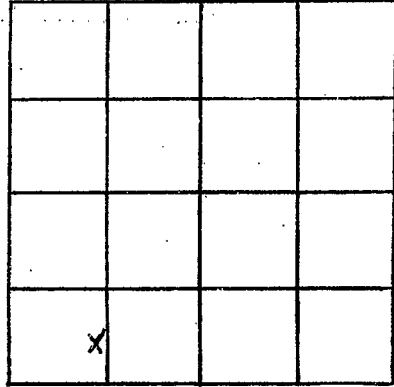

SECTION 3

Please indicate well location X.

ADDITIONAL INFORMATION

If more than one screen, show locations of each on sketch.