

Tate  
C 2051  
5-8-79

MISSISSIPPI  
BOARD OF WATER COMMISSIONERS  
416 North State Street  
Jackson, Mississippi 39201

WATER WELL DRILLERS LOG

5-8-79 19 date well completed  
Richs Well Co. firm name  
Tate county well located

LANDOWNER:  
Jack Handrick  
Rt. 2, Coldwater Miss.  
(mailing address)

description of formations encountered	from	to
Red sand	0	20
Red Clay & Red sand	20	60
Red sand	60	100
white sand	100	155

WELL LOCATION:  
sec. 36 T 4 N R 6 E  
1 miles W of Rott  
(distance) (direction) (nearest town)

WELL PURPOSE: home  
(home, irrigation, municipal, industrial)

WELL COMPLETION DATA:

(1) diameter (inches) 4 in

(2) total depth (feet) 155 ft

(3) static water level (feet) 80 below top of ground.

(4) casing Plastic 155 ft (material) (depth)

(size) if telescope see back.

(5) screen 7 ft 1 1/2 ft (length) (depth to top)

4 in gravel (size) (material)

(6) pump 1/2 10 (HP) (yield gpm)

220 (type power)

(7) electric log No (yes or no)

(organization running log)

(8) how well bottom plugged Cap

DRILLERS REMARKS:


Miss. Board of Water Comm.

MAY 14 1979

RECEIVED

If well telescopes please sketch and show depths.

GROUND LEVEL

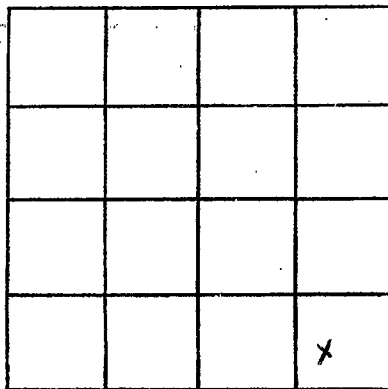

SECTION 36

Please indicate well location X.

ADDITIONAL INFORMATION

If more than one screen,  
show locations of each on sketch.