

Tate
 C 2053
 6-18-79

MISSISSIPPI
 BOARD OF WATER COMMISSIONERS
 416 North State Street
 Jackson, Mississippi 39201

WATER WELL DRILLERS LOG

6-18-79 19 799 Dicko Well Co Tate
 date well completed firm name county well located

LANDOWNER:
 Betty Buford
 Independence Miss
 (mailing address)

description of formations encountered	from	to
Red clay	0	20
clay & sand	20	90
White sand	90	155

WELL LOCATION:
 sec. 26-4 N R 6 E
 S Independence
 (distance) miles (direction) of (nearest town)

WELL PURPOSE: home
 (home, irrigation, municipal, industrial)

- WELL COMPLETION DATA:
- (1) diameter (inches) 4 in
 - (2) total depth (feet) 155
 - (3) static water level (feet) _____ below above top of ground.
 - (4) casing Photo 155
 (material) (depth)
 (size) if telescope see back.
 - (5) screen 7 ft 148
 (length) (depth to top)
4 in brass
 (size) (material)
 - (6) pump 1/2 10
 (HP) (yield gpm)
220
 (type power)
 - (7) electric log No
 (yes or no)
 - (organization running log)
 - (8) how well bottom plugged cap

Miss. Board of Water Comm.


JUN 29 1979

RECEIVED

DRILLERS REMARKS:

If well telescopes please sketch and show depths.

GROUND LEVEL

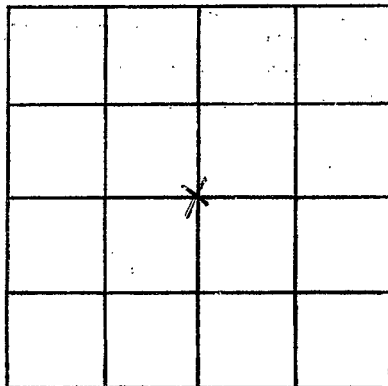

SECTION 26

Please indicate well location X.

ADDITIONAL INFORMATION

If more than one screen, show locations of each on sketch.