

Tate
 C 2055
 9-4-79

MISSISSIPPI
 BOARD OF WATER COMMISSIONERS
 416 North State Street
 Jackson, Mississippi 39201

WATER WELL DRILLERS LOG

9-4-79 1979 Hecks Well Co. Tate
 date well completed firm name county well located

LANDOWNER:
 James Darnell
 Rt. 3, Coldwater Miss.
 (mailing address)

description of formations encountered	from	to
Red Clay	0	25
White Clay	25	60
White Sand	60	125

WELL LOCATION:
 sec. 1 T 4 N R. 6 E
 1 1/2 miles N of (Waterfield)
 (distance) (direction) (nearest town)

WELL PURPOSE: home
 (home, irrigation, municipal, industrial)

WELL COMPLETION DATA:
 (1) diameter (inches) 4 in
 (2) total depth (feet) 125
 (3) static water level (feet) _____ below above top of ground.
 (4) casing Plastic 125 (material) (depth)
 (size) If telescope see back.
 (5) screen 7 ft 11 ft (length) (depth to top)
 4 in Bronal (size) (material)
 (6) pump 1/2 10 (HP) (yield gpm)
 220 (type power)
 (7) electric log No (yes or no)
 (organization running log)
 (8) how well bottom plugged Cap

DRILLERS REMARKS:


Miss. Board of Water Comm

SEP 11 1979

RECEIVED

If well telescopes please sketch and show depths.

GROUND LEVEL

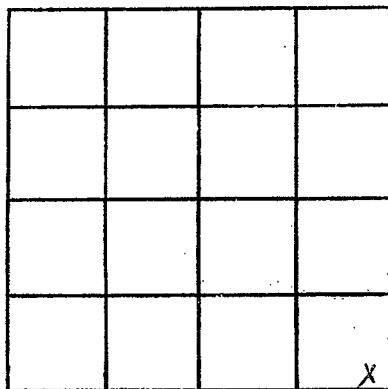

SECTION 1

Please indicate well location X.

ADDITIONAL INFORMATION

If more than one screen, show locations of each on sketch.