

MISSISSIPPI
BOARD OF WATER COMMISSIONERS
416 North State Street
Jackson, Mississippi 39201

Tate
C 2057
10-4-79

WATER WELL DRILLERS LOG

10/4/79 19 Bob Smith Tate
date well completed firm name county well located

LANDOWNER: A. B. Coleman
Coldwater
(mailing address)

description of formations encountered	from	to
Top Soil	0	5
red clay	10	30
red sand	30	50
red gravel	50	65
White Sand	65	130

WELL LOCATION:
sec. 12 T 4 N 3 R 6 E
4 miles W of Coldwater
(distance) (direction) (nearest town)

WELL PURPOSE:
(home, irrigation, municipal, industrial)

- WELL COMPLETION DATA:
- (1) diameter (inches) 4"
 - (2) total depth (feet) 130'
 - (3) static water level (feet) 100' below above top of ground.
 - (4) casing plastic 130'
(material) (depth)
(size) if telescope see back.
 - (5) screen 10' 100'
(length) (depth to top)
4"
(size) plastic
(material)
 - (6) pump 1/2 10
(HP) (yield gpm)
elec.
(type power)
 - (7) electric log (yes or no)
(organization running log)
 - (8) how well bottom plugged Cap

DEPT. OF NATURAL RESOURCES
BUREAU OF LAND & WATER RESOURCES


DEC 10 1979

RECEIVED

DRILLERS REMARKS:

If well telescopes please sketch and show depths.

GROUND LEVEL

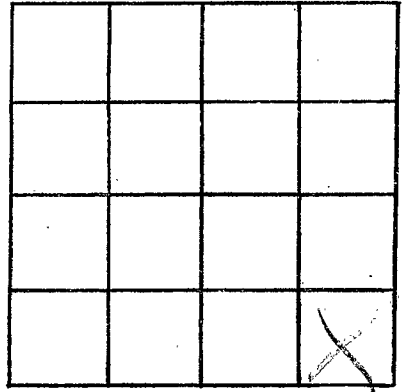

SECTION _____

Please indicate well location X.

ADDITIONAL INFORMATION

If more than one screen,
show locations of each on sketch.