

TATE
C 2059
3-5-80
3-5-

MISSISSIPPI
BOARD OF WATER COMMISSIONERS
416 North State Street
Jackson, Mississippi 39201

WATER WELL DRILLERS LOG

80 Nichols Woods Tate

date well completed

firm name

county well located

LANDOWNER:

John Scroggs
841 Independence
(mailing address)

description of formations encountered

from

to

Clay	0	30
Black Clay	30	130
White Clay	130	155

WELL LOCATION:

sec. 15 T-4 N R-6 E
2 miles of Independence
(distance) (direction) (nearest town)

WELL PURPOSE: home
(home, irrigation, municipal, industrial)

WELL COMPLETION DATA:

- (1) diameter (inches) 4 in
- (2) total depth (feet) 155
- (3) static water level (feet) 90 below top of ground.
- (4) casing Plastic 155 (material) (depth)
- (size) If telescope see back.
- (5) screen 7 ft 1 1/2 (length) (depth to top)
- 4 Gravel (size) (material)
- (6) pump 1/2 10 (HP) (yield gpm)
- 220 (type power)
- (7) electric log NO (yes or no)
- (organization running log)
- (8) how well bottom plugged Cap

DEPT. OF NATURAL RESOURCES
BUREAU OF LAND & WATER RESOURCES


APR - 9 1980

RECEIVED

DRILLERS REMARKS:

If well telescopes please sketch and show depths.

GROUND LEVEL

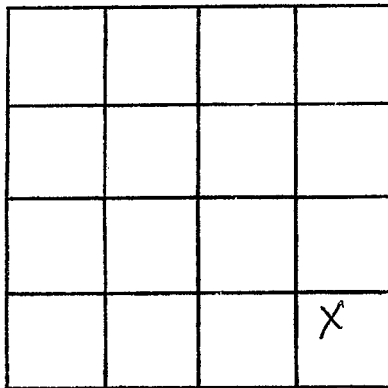

SECTION 15

Please indicate well location X.

ADDITIONAL INFORMATION

If more than one screen, show locations of each on sketch.