

TATE
 C 2060
 4-2-80

MISSISSIPPI
 BOARD OF WATER COMMISSIONERS
 416 North State Street
 Jackson, Mississippi 39201

WATER WELL DRILLERS LOG

4-2 1980 Tates Well Co. Tate
 date well completed firm name county well located

LANDOWNER:
 Jimmie Sneed
 Palestine Miss.
 (mailing address)

description of formations encountered	from	to
	Brown Clay	0
red sand	20	70
white sand	70	155
Plastic		

WELL LOCATION:
 sec. 17 T 4 N R 6 E
 3 1/2 miles W of Pumping Station
 (distance) (direction) (nearest town)

WELL PURPOSE: Home
 (home, irrigation, municipal, industrial)

WELL COMPLETION DATA:
 (1) diameter (inches) 4 in
 (2) total depth (feet) 155
 (3) static water level (feet) 120 below top of ground
 (4) casing Plastic 155 (material) (depth)
 (size) If telescope see back.
 (5) screen 72 148 (length) (depth to top)
 4 in Gravel (size) (material)
 (6) pump 1/2 10 (HP) (yield gpm)
 220 (type power)
 (7) electric log No (yes or no)
 (organization running log)
 (8) how well bottom plugged Cap


DRILLERS REMARKS:

DEPT. OF NATURAL RESOURCES
 BUREAU OF LAND & WATER RESOURCES

APR 29 1980
 RECEIVED

If well telescopes please sketch and show depths.

GROUND LEVEL

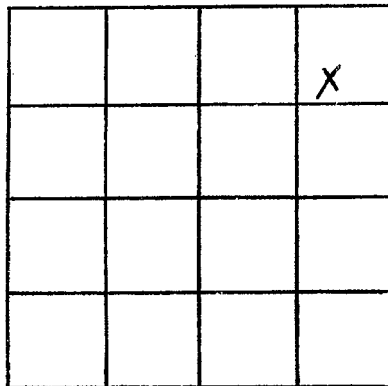

SECTION 17

Please indicate well location X.

ADDITIONAL INFORMATION

If more than one screen,
show locations of each on sketch.