

TATE
 C 2066
 10-1-80

MISSISSIPPI
 BOARD OF WATER COMMISSIONERS
 416 North State Street
 Jackson, Mississippi 39201

WATER WELL DRILLERS LOG

10-1 1980 BIG STREAM TATE
 date well completed firm name county well located

LANDOWNER: JAMES T TYNER
 Independence
 Miss
 (mailing address)

description of formations encountered	from	to
BROWN CLAY	0	20
Brown Sand	20	110
WHITE WATER SAND	110	140

WELL LOCATION:
 sec 25 T 4 N R 6 E
 1 1/2 miles E of INDEPENDENCE
 (distance) (direction) (nearest town)

WELL PURPOSE:
 (home, irrigation, municipal, industrial)

- WELL COMPLETION DATA:
- (1) diameter (inches) 4"
 - (2) total depth (feet) 140
 - (3) static water level (feet) 80 below top of ground.
 - (4) casing PVC 130 (material) (depth)
 4" (size) if telescope see back.
 - (5) screen 10 130 (length) (depth to top)
 4" PVC (size) (material)
 - (6) pump 3/4 10 (HP) (yield gpm)
 ELECT (type power)
 - (7) electric log NO (yes or no)
 - (organization running log)
 - (8) how well bottom plugged BACK W

DEPT. OF NATURAL RESOURCES
 BUREAU OF LAND & WATER RESOURCES


OCT 17 1980

RECEIVED

DRILLERS REMARKS:
 NEW DRILLER
 JB CAIN OWNER

If well telescopes please sketch and show depths.

GROUND LEVEL

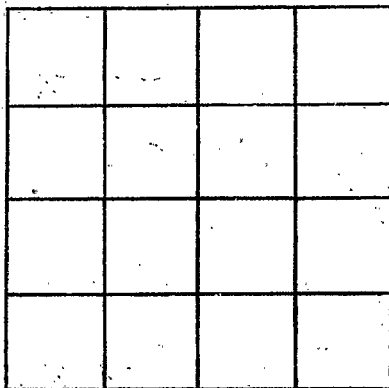

SECTION _____

Please indicate well location X.

ADDITIONAL INFORMATION

MR REELE
I NED SOME LOG
BOOKS AND SOM MAPS
ONE OF EACH
MARSHALL CO TONICA CO
DESOTA CO

THANK YOU

BIG STREAM WELL DR
INC
J B CAIN

If more than one screen,
show locations of each on sketch.