

TATE
C 2065
10-8-80

MISSISSIPPI
BOARD OF WATER COMMISSIONERS
416 North State Street
Jackson, Mississippi 39201

WATER WELL DRILLERS LOG

10-8 1980 date well completed
Hicks Well Co. firm name
Tate county well located

LANDOWNER: W.L. Bradick Jr.
3775 Cayuga St
Memphis, TN
(mailing address)

description of formations encountered	from	to
Red clay	0	15
Red sand	15	60

WELL LOCATION:

sec. 26 T 4 N R 6 E
1 miles E of Independence
(distance) (direction) (nearest town)

White sand	60	110
------------	----	-----

WELL PURPOSE:

(home, irrigation, municipal, industrial)

WELL COMPLETION DATA:

- (1) diameter (inches) 4
- (2) total depth (feet) 110
- (3) static water level (feet) 60 below top of ground.
- (4) casing PVC, 110 (material), (depth)
- (size) If telescope see back.
- (5) screen 7' length, 103 (depth to top)
- 4" gravel type (size), (material)
- (6) pump 1/2 HP, 10 (yield gpm)
- 220V (type power)
- (7) electric log No (yes or no)

(organization running log)

- (8) how well bottom plugged Cap

DRILLERS REMARKS:


DEPT. OF NATURAL RESOURCES
BUREAU OF LAND & WATER RESOURCES

OCT 29 1980

RECEIVED

If well telescopes please sketch and show depths.

GROUND LEVEL

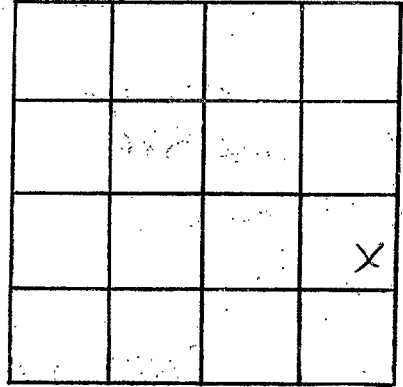

SECTION 26

Please indicate well location X.

ADDITIONAL INFORMATION

If more than one screen,
show locations of each on sketch.