

MISSISSIPPI DEPARTMENT OF NATURAL RESOURCES
Bureau of Land and Water Resources
 Southport Mall
 P.O. Box 10631
 Jackson, Mississippi 39209
WATER WELL DRILLERS LOG

12

TATE
C 2066
11-24-80

11-24 1980 Hicks Well Co. Tates
 date well completed firm name county well located

LANDOWNER: H.M. Wallace
Rt. 3
Caldwate, Ms.
 (mailing address)

description of formations encountered	from	to
<u>Red Clay</u>	<u>0</u>	<u>10</u>
<u>Gravel + Sand</u>	<u>10</u>	<u>65</u>
<u>White Sand</u>	<u>65</u>	<u>160</u>
<u>Dark - Black Clay</u>	<u>160</u>	<u>170</u>

WELL LOCATION:
 sec. 15 T 4 N R 6 E
3 miles N of Indesena
 (distance) (direction) (nearest town)

WELL PURPOSE: Home
 (home, irrigation, municipal, industrial)

- WELL COMPLETION DATA:
- diameter (inches) 4
 - total depth (feet) 170
 - static water level (feet) 80 below top of ground.
 - casing PVC 170
 (material) (depth)
 (size) If telescope see back.
 - screen 12 138
 (length) (depth to top)
2 1/2" gravel type
 (size) (material)
 - pump 1/2 10
 (HP) (yield gpm)
115V
 (type power)
 - electric log No
 (yes or no)
 (organization running log)
 - how well bottom plugged Cap

DRILLERS REMARKS:


DEPT. OF NATURAL RESOURCES
 BUREAU OF LAND & WATER RESOURCES

DEC - 3 1980

RECEIVED

If well telescopes please sketch and show depths.

GROUND LEVEL

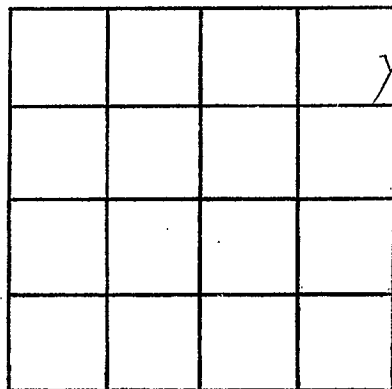

SECTION 15

Please indicate well location X.

ADDITIONAL INFORMATION

If more than one screen,
show locations of each on sketch.