

Date
 C
 2007

MISSISSIPPI
 BOARD OF WATER COMMISSIONERS
 416 North State Street
 Jackson, Mississippi 39201

WATER WELL DRILLERS LOG

7-3-80 date well completed
 Bob Smith/Walbe firm name
 Tate county well located

LANDOWNER:
 Pete Ditto
 Wakefield, MS.
 (mailing address)

description of formations encountered	from	to
top soil	0	5
Red clay	5	30
Red sand	30	65
White sand	65	120

WELL LOCATION:
 sec. 11 T-4 N R-6 E
 (S) (W)
 2 miles N of Wakefield
 (distance) (direction) (nearest town)

WELL PURPOSE:
 (home) irrigation, municipal, industrial

WELL COMPLETION DATA:

(1) diameter (inches) 4"

(2) total depth (feet) 120'

(3) static water level (feet) 70' below above top of ground.

(4) casing 4" (material) 120' (depth)
 (size) if telescope see back.

(5) screen 10' (length) 110' (depth to top)
 4" (size) plastic (material)

(6) pump 1/2 (HP) 10 (yield gpm)
 Elec. (type power)

(7) electric log (yes of no)

(organization running log)

(8) how well bottom plugged cap

DRILLERS REMARKS:


DEPT. OF NATURAL RESOURCES
 BUREAU OF LAND & WATER RESOURCES

JUN 15 1982

RECEIVED

If well telescopes please sketch and show depths.

GROUND LEVEL

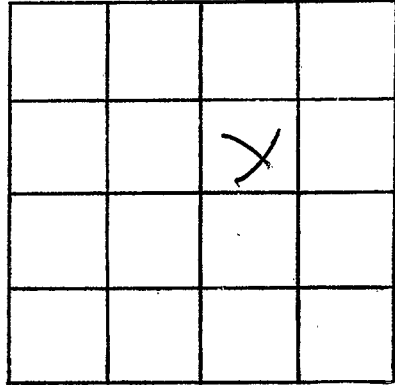

SECTION _____

Please indicate well location X.

ADDITIONAL INFORMATION

If more than one screen,
show locations of each on sketch.