

MISSISSIPPI DEPARTMENT OF NATURAL RESOURCES

Bureau of Land and Water Resources

Southport Mall

P.O. Box 10631

Jackson, Mississippi 39209

WATER WELL DRILLERS LOG

TATE
C 2008
6/12/81

6-12-81 date well completed 81 Hichs Well Co. firm name Tate county well located

LANDOWNER: Jerry Pipkin
 P.O. Box 73
 Senatobia, Ms.
 (mailing address)

WELL LOCATION:
 sec. 4 T 4 N R 6 E
 (distance) miles (direction) of Greenleaf (nearest town)

description of formations encountered	from	to
Red Clay	0	15
Red sand & gravel	15	60
White sand	60	125

WELL PURPOSE: Pump
 (home, irrigation, municipal, industrial)

WELL COMPLETION DATA:

(1) diameter (inches) 4

(2) total depth (feet) 125

(3) static water level (feet) 80 below top of ground.


(4) casing PVC, 125 (material) (depth)
 (size) If telescope see back.

(5) screen 12' (length) 123' (depth to top)
 4" (size) gravel type (material)

(6) pump 1/2 (HP) 10 (yield gpm)
 220V (type power)

(7) electric log No (yes or no)
 (organization running log)


(8) how well bottom plugged Cap

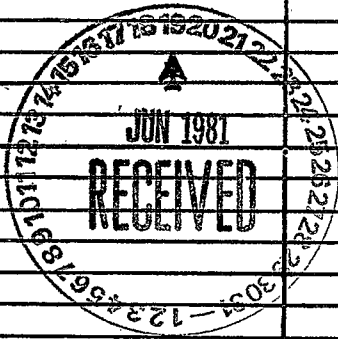

DRILLERS REMARKS:

If well telescopes please sketch and show depths.

GROUND LEVEL

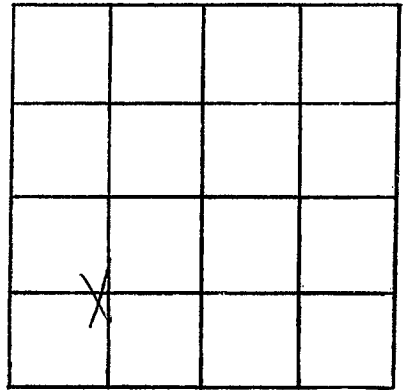

SECTION 24

Please indicate well location X.

ADDITIONAL INFORMATION

If more than one screen,
show locations of each on sketch.