

MISSISSIPPI DEPARTMENT OF NATURAL RESOURCES

Bureau of Land and Water Resources

Southport Mall

P.O. Box 10631

Jackson, Mississippi 39209

WATER WELL DRILLERS LOG

Tate
Caddo
6-16-81

6-16 1981 Hicks Well Co. Tate
 date well completed firm name county well located

LANDOWNER: Independence Masonic Lodge
Independence, MS
 (mailing address)

description of formations encountered	from	to
<u>Red Clay</u>	<u>0</u>	<u>10</u>
<u>Red Sand & gravel</u>	<u>10</u>	<u>70</u>
<u>white sand</u>	<u>70</u>	<u>117</u>

WELL LOCATION:
 sec. 26 T 4 N R. 6 E
S W
 (distance) miles (direction) of Independence
 (nearest town)

WELL PURPOSE: Fudge
 (home, irrigation, municipal, industrial)

WELL COMPLETION DATA:

(1) diameter (inches) 2

(2) total depth (feet) 117

(3) static water level (feet) 80 below above top of ground.

(4) casing PVC, 117,
 (material) (depth)
 (size) If telescope see back.


(5) screen 7, 110
 (length) (depth to top)
4", gravel type
 (size) (material)

(6) pump 1/2, 10
 (HP) (yield gpm)
220V
 (type power)

(7) electric log No
 (yes or no)

(organization running log)


(8) how well bottom plugged Cop

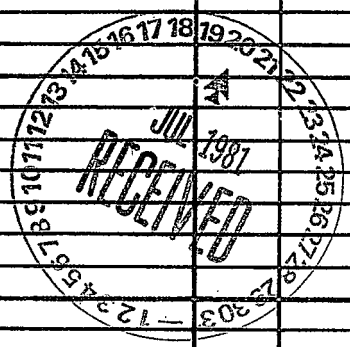

DRILLERS REMARKS:

If well telescopes please sketch and show depths.

GROUND LEVEL

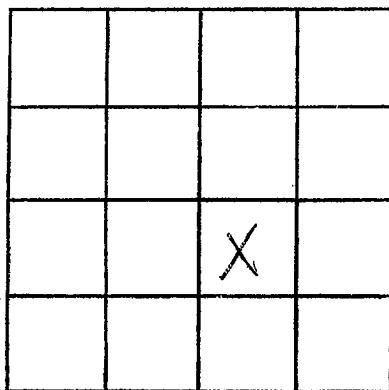

SECTION 26

Please indicate well location X.

ADDITIONAL INFORMATION

If more than one screen,
show locations of each on sketch.